



Application Number: LU/15334(TP187/2022)

Our File Reference Number: Erf 12042, Stellenbosch

Your Reference Number:

Enquiries: Ulrich von Molendorff

Contact No: 021 808 8682

Email address: Ulrich.Vonmolendorff@stellenbosch.gov.za

PER E-MAIL: [REDACTED]

Sir/Madam

APPLICATION FOR TECHNICAL APPROVAL AND PERMANENT DEPARTURE ON ERF 12042, STELLENBOSCH

1. The above application refers.
 2. The duly authorised decision maker has decided on the above application as follows:
 - 2.1 That the application made in terms of Stellenbosch Municipal Land Use Planning By-Law, promulgated by notice number 354/2015, dated October 2015, on Erf 12042, Stellenbosch for the following:
 - 2.1.1 **Permission/ Technical Approval** in terms of Section 15 (2) (g) of the said by-law in order to accommodate a second dwelling unit on the basement storey.
- BE REFUSED** in terms of Section 60 of the said bylaw.
- 2.2 The reasons for the above decision are as follows:
 - 2.2.1 The proposed second dwelling unit is not permissible on a group housing development.
 3. That the application made in terms of Stellenbosch Municipal Land Use Planning By-Law, promulgated by notice number 354/2015, dated October 2015, on Erf 12042, Stellenbosch for the following:
 - 3.1 **Permanent Departure** in terms of Section 15 (2) (b) of the said by-law, to exceed the allowed number of storeys and accommodate the existing basement storey as a third storey.

BE APPROVED in terms of Section 60 of the by law and subject to the following conditions in terms of Section 66 of the said Bylaw:

4. Conditions of approval

4.1 The approval applies only to the application under consideration as indicated on Drawing Number A100-A104, drawn by LT (Laryssa Prins Architects), dated 10/31/22 and shall not be construed as authority to depart from any other legal prescriptions or requirements from Council.

4.2 The development shall be implemented substantially in accordance with the Drawing Number A100-A104, drawn by LT (Laryssa Prins Architects), dated 10/31/22 attached as **Annexure C**.

4.3 The approval granted shall not exempt the applicant from complying with any other legal prescriptions or requirements that might have a bearing on the proposed use.

4.4 Building plans must be generally in accordance with the site development plan referenced as Drawing Number A100-A104, drawn by LT (Laryssa Prins Architects), dated 10/31/22 as **Annexure C**.

4.5 Please be aware of the municipal sewer line along the southern boundary of the erf. The exact position of the sewer line must be indicated on all building plans. The building plans must include a cross section that clearly indicates the position and depth of the sewer line in relation to the proposed basement structure. Building plans will only be approved if the proposed basement does not clash with the sewer line and if it does not put the sewer line at risk of being damaged. Notwithstanding the above, any damage to the sewer line, should it occur, will be for the Owner's account.

5. The reasons for the above decision are as follows:

5.1 The application will not negatively affect the residential aesthetic of the property or surrounding environment and the primary use of the property will remain residential.

6. You are hereby informed in terms of section 79(2) of the Stellenbosch Municipal Land Use Planning Bylaw, 2015, of your right to appeal the above decision to the Appeal Authority within 21 days from the date of notification of the above decision. Please note that no late appeals or an extension of time for the submission of appeals are permitted in terms of Section 80(1)(a) of the said By-Law.

7. Appeals must be submitted with the prescribed information to satisfy the requirements of Section 80(2) of the said By-law, failing which the appeal will be invalid in terms of Section 81(1)(b) of the said By-Law. The following prescribed information is accordingly required:

(a) The personal particulars of the Appellant, including:

- (I) First names and surname;
- (II) ID number;
- (III) Company of Legal person's name (if applicable)
- (IV) Physical Address;
- (V) Contact details, including a Cell number and E-Mail address;

(b) Reference to this correspondence and the relevant property details on which the appeal is submitted.

(c) The grounds of the appeal which may include the following grounds:

- (i) that the administrative action was not procedurally fair as contemplated in the Promotion of Administrative Justice Act, 2000 (Act 3 of 2000);
- (ii) grounds relating to the merits of the land development or land use application on which the appellant believes the authorised decision maker erred in coming to the conclusion it did.

(d) whether the appeal is lodged against the whole decision or a part of the decision;

(e) if the appeal is lodged against a part of the decision, a description of the part;

(f) if the appeal is lodged against a condition of approval, a description of the condition;

(g) the factual or legal findings that the appellant relies on;

(h) the relief sought by the appellant; and


(i) any issue that the appellant wishes the Appeal Authority to consider in making its decision;

(j) That the appeal includes the following declaration by the Appellant:

- (i) The Appellant confirms that the information contained in the subject appeal and accompanied information and documentation is complete and correct
 - (ii) That the Appellant is aware that it is an offence in terms of Section 86(1)(d) of the said By-Law to supply particulars, information or answers in an appeal against a decision on an application, or in any documentation or representation related to an appeal, knowing it to be false, incorrect or misleading or not believing them to be correct.
8. Appeals must be addressed to the Municipal Manager and submitted to his/ her designated official by means of E-mail at the following address: landuse.appeals@stellenbosch.gov.za
9. Any party (applicant or other) who lodges an appeal must pay the applicable appeal fee in terms of the approved municipal tariffs and submit the proof of payment together with the appeal. The **LU** Reference number on this correspondence, or the applicable Erf/ Farm Number must be used as the reference for the payment of the appeal fee.
10. The approved tariff structure and the banking details for the General Account can be accessed and viewed on the municipal website. For any enquiries the office can be contacted at landuse.appeals@stellenbosch.gov.za
11. An applicant who lodge an appeal must also adhere to the following requirements stipulated in terms of section 80(3) to (7) of the said By-law:
- (a) Simultaneously serve the appeal on any person who commented on the application concerned and any other person as the municipality may determine.
 - (b) The notice by the applicant must invite persons to comment on the appeal within 21 days from date of notification of the appeal.
 - (c) The notice must be served in accordance with section 35 of the said legislation and in accordance with the prescripts or such additional requirements as may be determined by the Municipality.
 - (d) Proof of serving the notification must be submitted to the Municipality at the above E-mail address within 14 days of serving the notification.
12. Kindly note that no appeal right exists in terms of Section 62 of the Local Government Municipal Systems Act, No 32 of 2000.


13. Kindly note the above decision is suspended, and in the case of any approval, may therefore not be acted on, until such time as the period for lodging appeals has lapsed, any appeal has been finalised and you've been advised accordingly.

Yours faithfully

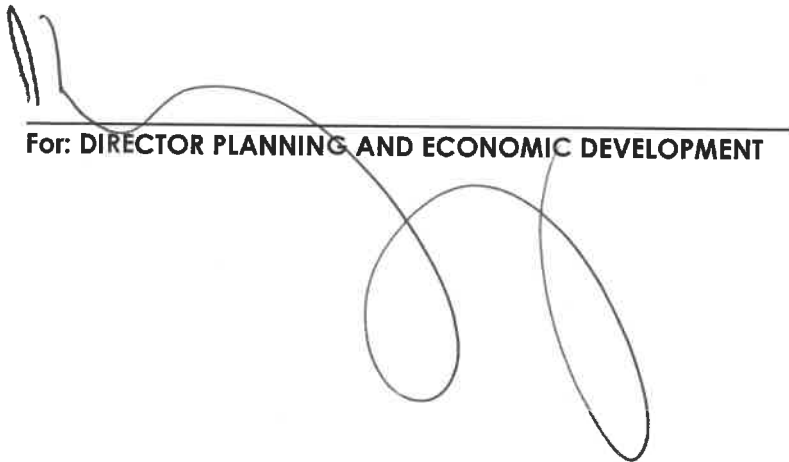

A large, stylized handwritten signature in black ink, consisting of several loops and a long horizontal stroke, positioned over a horizontal line.

For: DIRECTOR PLANNING AND ECONOMIC DEVELOPMENT

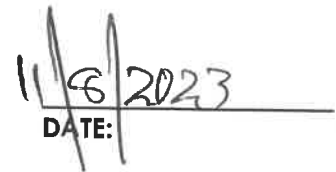

A handwritten date '11/6/2023' in black ink, positioned over a horizontal line.

DATE:

**ANNEXURE C: SITE DEVELOPMENT PLAN (INITIAL AND
AMENDED)**

PROJECT IDENTIFICATION:

ADDRESS: 10 Red Oak
ERF: 12042
ZONING: GROUP HOUSING
SITE AREA: 280m²


AREAS:

AS BUILT BASEMENT
EXISTING GROUND STOREY
EXISTING COVERED STOEP
EXISTING FIRST STOREY
EXISTING BALCONY

60.0m²
108.0m²
20.0m²
111.0m²
9.0m²

128m²
45.7%

EXISTING COVERED AREA ON GROUND STOREY
EXISTING COVERAGE

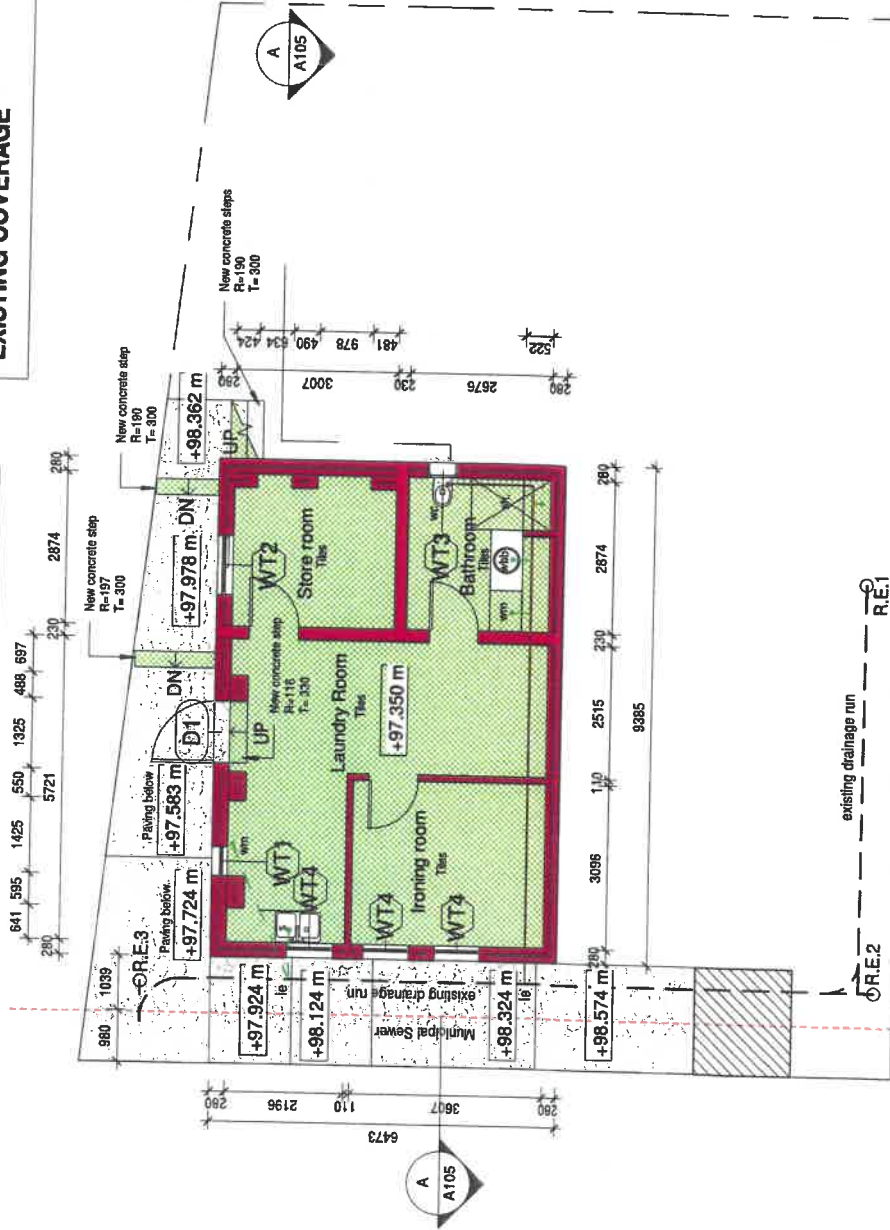

-01 Basement Storey
1 : 100

Rev	Description	Date
A	WHOIA Submission	20220623
B	Drainage Section and Ceiling height	20221031
C	Drainage	20230723

COUNCIL NOTES

- GENERAL:
1. ALL WORK TO BE DONE IN ACCORDANCE WITH SANS 10400.
 2. SANS 10400 TO BE SATISFIED PER MEANS SPECIFIED IN SCHEDULE A AND B, SANS 10400-A: FORM 1.
 3. DO NOT SCALE. REFER ONLY TO FIGURED DIMENSIONS.
 4. ALL LEVELS, DIMENSIONS, GRADIENTS AND STEPS TO BE CHECKED ON SITE PRIOR TO CONSTRUCTION AND ANY DISCREPANCIES TO BE REPORTED TO THE ARCHITECT IMMEDIATELY.
- STRUCTURAL DESIGN:
- NO STRUCTURAL ENGINEER HAS BEEN APPOINTED ACCORDING TO FORM 1. THE STRUCTURAL SYSTEM TO COMPLY WITH THE DETAIL REQUIREMENTS OF SANS 10400 PARTS 1, 2, 3, 99, 100.
- PROVISION OF SANITARY FACILITIES DURING CONSTRUCTION TO COMPLY WITH THE DETAIL REQUIREMENTS OF SANS 10400-0. SUBMIT PROPOSAL TO THE ARCHITECT FOR APPROVAL.
- FOUNDATIONS:
- ALL FOUNDATIONS ACCORDING TO STRUCTURAL ENGINEER'S DESIGN UNLESS OTHERWISE SPECIFIED IN FORM 1.
- ALL DEEP FOOTINGS, SOIL PACTS COMPACTED AND SUB-SURFACE DRAINAGE ACCORDING TO CIVIL ENGINEER'S DETAILS UNLESS OTHERWISE SPECIFIED IN FORM 1.
- WALLS:
1. STRUCTURAL STRENGTH AND STABILITY OF WALLS TO STRUCTURAL ENGINEERS APPROVAL UNLESS OTHERWISE SPECIFIED IN FORM 1.
 2. ALL CLAY MASONRY OR CONCRETE BLOCK WALLS TO BE CONSTRUCTED IN STANDARD SIZE CLAY BRICKS OR STANDARD SIZE CONCRETE BLOCKS.
 3. ROOF COVERINGS, WATERPROOFING SYSTEMS, AND FLAT ROOFS, GUTTERS AND DOWN PIPES TO COMPLY WITH THE DETAIL REQUIREMENTS OF SANS 10400-L AND SANS 10400-R UNLESS OTHERWISE SPECIFIED IN FORM 1.
 4. FIRE RESISTANCE AND COMBUSTIBILITY OF ROOF AND CEILING ASSEMBLY TO COMPLY WITH FIRE ENGINEER'S REQUIREMENTS UNLESS OTHERWISE SPECIFIED IN FORM 1.
 5. HEALTH & PUBLIC SAFETY:
1. CHANGES IN LEVEL, RAMPS AND DRIVEWAYS, AND ACCESS TO SWIMMING POOLS TO COMPLY WITH SANS THE DETAIL REQUIREMENTS OF SANS 10400-D UNLESS OTHERWISE SPECIFIED IN FORM 1.
2. STOREROOMS & DISCONNECTING LOBBIES TO ALL TOILETS TO BE INDEPENDENTLY AND ADEQUATELY LIT & VENTILATED IN COMPLIANCE WITH SANS 10400-C.
3. THE MEANS FOR PROVIDING FACILITIES FOR PEOPLE WITH DISABILITIES IS IN ACCORDANCE WITH SANS 10400-S UNLESS OTHERWISE SPECIFIED IN FORM 1.
- DRAINAGE & STORMWATER:
1. DRAINAGE SYSTEM TO COMPLY WITH THE DETAIL REQUIREMENTS OF SANS 10400-P UNLESS OTHERWISE SPECIFIED IN FORM 1.
2. STORMWATER SYSTEM TO COMPLY WITH THE DETAIL REQUIREMENTS OF SANS 10400-R UNLESS OTHERWISE SPECIFIED IN FORM 1.
3. MATERIALS AND FINISHES:
1. MATERIALS AND FINISHES AS INDICATED ON THE DRAWINGS. MATERIAL NOTES AND/OR FINISHES SCHEDULES.
2. MASONRY WALLS TO BE PLASTERED AND PAINTED UNLESS OTHERWISE SPECIFIED ON THE DRAWINGS.

WELGEVONDEN
ESTATE

Client
Sarel Etsebeth
15/07/22

Project
10 Red Oak, Welgevonden

Drawing
Basement Storey Plan

Scale
1 : 100

Date
10/31/22

Drawn
LT

Project No.
A100

Drawing No.
A100


Revision No.
C

Window Schedule

Type Mark	Description	Width	Height	Sill Height	Count
WT1	Top hung aluminium frame window with fixed bottom panel	557	920	1225	1
WT2	Top hung aluminium frame window with fixed bottom and side panels	1120	1112	1028	1
WT3	Top hung aluminium frame window	560	560	1717	1
WT4	Top hung aluminium frame window with fixed bottom panel	650	940	968	3

COUNCIL NOTES

- GENERAL:
1. ALL WORK TO BE DONE IN ACCORDANCE WITH SANS 10400
2. SANS 10400 TO BE SATISFIED PER MEANS SPECIFIED IN SCHEDULE A AND 8, SANS 10400-A: FORM 1.
3. DO NOT SCALE. REFER ONLY TO FIGURED DIMENSIONS.
4. ALL LEVELS, DIMENSIONS, GRADIENTS AND STEPS TO BE CHECKED ON SITE PRIOR TO CONSTRUCTION AND ANY DISCREPANCIES TO BE REPORTED TO THE ARCHITECT IMMEDIATELY.
5. THE ARCHITECT'S DESIGN:
6. THE ARCHITECT HAS BEEN APPOINTED ACCORDING TO FORM 1 THE STRUCTURAL SYSTEM TO COMPLY WITH THE DETAIL REQUIREMENTS OF SANS 10400 PARTS H, J, K, L, M, N AND IN THE CASE OF TOWER BUILDINGS WITH SANS 10082.
7. SITE OPERATIONS:
8. PROVISION OF SANITARY FACILITIES DURING CONSTRUCTION TO COMPLY WITH THE DETAIL REQUIREMENTS OF SANS 10400-D. SUBMIT PROPOSAL TO THE ARCHITECT FOR APPROVAL.
9. FOUNDATIONS:
10. ALL FOUNDATIONS ACCORDING TO STRUCTURAL ENGINEER'S DESIGN UNLESS OTHERWISE SPECIFIED IN FORM 1.
11. ALL DEEP FOOTINGS, SOIL RAFTS COMPACTION AND SUB-SURFACE DRAINAGE, ACCORDING TO CIVIL ENGINEER'S DETAILS UNLESS OTHERWISE SPECIFIED IN FORM 1.
12. WALLS:
13. STRUCTURAL STRENGTH AND STABILITY OF WALLS TO STRUCTURAL ENGINEER'S DESIGN UNLESS OTHERWISE SPECIFIED IN FORM 1.
14. SPECIAL REQUIREMENTS ON CONCRETE BLOCK WALLS TO BE CONSTRUCTED IN STANDARD SIZE CLAY BRICKS OR STANDARD SIZE CONCRETE BLOCKS.
15. ROOFS:
16. ROOF COVERINGS WATERPROOFING SYSTEMS, AND FLAT ROOFS, GUTTERS AND DOWNS PIPES TO COMPLY WITH THE DETAIL REQUIREMENTS OF SANS 10400-L AND SANS 10400-R UNLESS OTHERWISE SPECIFIED IN FORM 1.
17. FIRE RESISTANCE AND COMBUSTIBILITY OF ROOF AND CEILING ASSEMBLY TO COMPLY WITH FIRE ENGINEER'S REQUIREMENTS UNLESS OTHERWISE SPECIFIED IN FORM 1.
18. HEALTH & PUBLIC SAFETY:
19. CHANGES IN LEVEL, RAMP, AND DRIVEWAYS, AND ACCESS TO SWIMMING POOLS TO COMPLY WITH SANS THE DETAIL REQUIREMENTS OF SANS 10400-D UNLESS OTHERWISE SPECIFIED IN FORM 1.
20. STOREROOMS & DISCONNECTING LOBBIES TO ALL TOILETS TO BE INDEPENDENTLY AND ADEQUATELY LIT & VENTILATED IN COMPLIANCE WITH SANS 10400-Q.
21. THE MEANS FOR PROVIDING FACILITIES FOR PEOPLE WITH DISABILITIES IS IN ACCORDANCE WITH SANS 10400-S UNLESS OTHERWISE SPECIFIED IN FORM 1.
22. DRAINAGE SYSTEMS:
23. DRAINAGE SYSTEMS TO COMPLY WITH THE DETAIL REQUIREMENTS OF SANS 10400-P UNLESS OTHERWISE SPECIFIED IN FORM 1.
24. STORMWATER DISPOSAL TO COMPLY WITH THE DETAIL REQUIREMENTS OF SANS 10400-R UNLESS OTHERWISE SPECIFIED IN FORM 1.
25. MATERIALS AND FINISHES:
26. FINISHES SCHEDULES
27. MASONRY WALLS TO BE PLASTERED AND PAINTED UNLESS OTHERWISE SPECIFIED ON THE DRAWINGS.

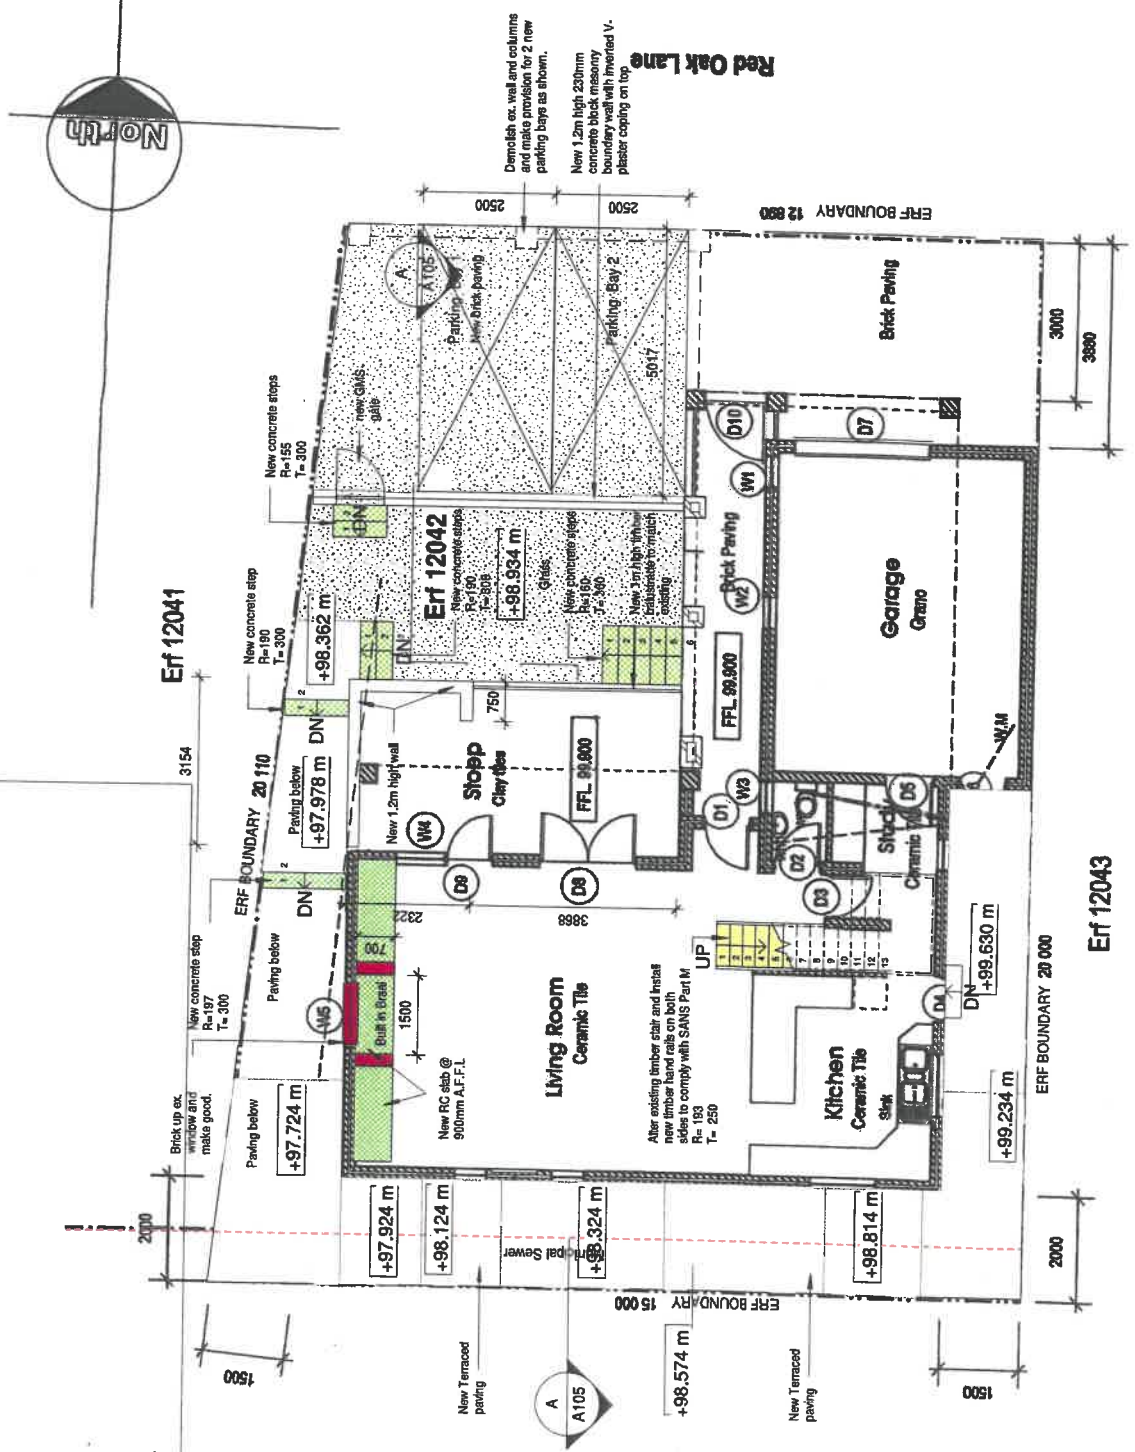

WELGEVONDEN ESTATE

Client: Sarel Etsebeth 15/01/23

Project: 10 Red Oak, Welgevonden

Drawing: Ground Storey Plan

Scale: 1:100

Date: 10/31/22

Drawn: LT

Project No.: A101

Drawing No.: A101

Revision No.: C

GENERAL: ALL WORK TO BE DONE IN ACCORDANCE WITH SANS 10400
PART 2, SANS 10400 TO BE SATISFIED PER MEANS SPECIFIED IN SCHEDULE A AND B, SANS 10400-A
AND B, FORM 1.
1:50.00 DO NOT SCALE. REFER ONLY TO FIGURED DIMENSIONS.
ALL LEVELS, DIMENSIONS, GRADIENTS AND STEPS TO BE CHECKED ON SITE PRIOR TO
CONSTRUCTION AND ANY DISCREPANCIES TO BE REPORTED TO THE ARCHITECT
IMMEDIATELY.

STRUCTURAL DESIGN:
IF NO STRUCTURAL ENGINEER HAS BEEN APPOINTED ACCORDING TO FORM 1 THE STRUCTURAL SYSTEM TO COMPLY WITH THE DETAIL REQUIREMENTS OF SANS 10400 PARTS 4, 4.4, 4.5, 4.6, 4.7, 4.8, 4.9, 4.10, 4.11, 4.12, 10.66,

PROVISION OF SANITARY FACILITIES DURING CONSTRUCTION TO COMPLY WITH THE DETAIL REQUIREMENTS OF SANS 10400-D. SUBMIT PROPOSAL TO THE ARCHITECT FOR APPROVAL.

ALL DEEP FOOTINGS, SOIL RAFTS COMPACTION AND SUB-SURFACE DRAINAGE ACCORDING TO CIVIL ENGINEER'S DETAILS UNLESS OTHERWISE SPECIFIED IN FORM 1.

STRUCTURAL STRENGTH AND STABILITY OF WALLS TO STRUCTURAL ENGINEER'S APPROVAL UNLESS OTHERWISE SPECIFIED IN FORM 1

ALL CLAY MASONRY OR CONCRETE BLOCK WALLS TO BE CONSTRUCTED IN STANDARD SIZE CLAY BRICKS OR STANDARD SIZE CONCRETE BLOCKS

ROOF COVERINGS, WATERPROOF SYSTEMS, AND FLAT ROOFS, GUTTERS AND DOWNPIPES TO COMPLY WITH THE DETAIL REQUIREMENTS OF SANS 10400-L AND SANS 10400-R UNLESS OTHERWISE SPECIFIED FORM 1

FIRE RESISTANCE AND COMBUSTIBILITY OF ROOF AND CEILING ASSEMBLY TO COMPLY WITH FIRE ENGINEER'S REQUIREMENTS UNLESS OTHERWISE SPECIFIED IN FORM 1.

CHANGES IN LEVEL, RAMPS AND DRIVEWAYS, AND ACCESS TO SWIMMING POOLS TO COMPLY WITH SANS, THE DETAIL REQUIREMENTS OF SANS 10400-D UNLESS OTHERWISE SPECIFIED IN FORM 1

STOREROOMS & DISCONNECTING LOBBIES TO ALL TOILETS TO BE INDEPENDENTLY AND ADEQUATELY LIT & VENTILATED IN COMPLIANCE WITH SANS 10400-O.

THE DESIGN FOR PROVIDING FACILITIES FOR PEOPLE WITH DISABILITIES IS IN ACCORDANCE WITH SANS 10400-S UNLESS OTHERWISE SPECIFIED IN FORM 1

DRAINAGE SYSTEM TO COMPLY WITH THE DETAIL REQUIREMENTS OF SANS 10400-P UNLESS OTHERWISE SPECIFIED IN FORM 1.

STORMWATER DISPOSAL TO COMPLY WITH THE DETAIL REQUIREMENTS OF SANS 10400-R
UNLESS OTHERWISE SPECIFIED IN FORM 1.
TERMS AND CONDITIONS:

MATERIALS AND FINISHES AS INDICATED ON THE DRAWINGS, MATERIAL NOTES AND/OR FINISHES SCHEDULES

MASONRY WALLS TO BE PLASTERED AND PAINTED UNLESS OTHERWISE SPECIFIED ON THE DRAWINGS.

Client
Sarel Etsebeth

Project	10 Red Oak, Welgevonden
10 Red Oak, Welgevonden	10 Red Oak, Welgevonden

[Signature]
Drawing
First Storey Plan

Scale As Indicated	Size	Date 10/31/22	Drawn LT
Project No. Project # A102			Revision No. C


LARYSSA PRINS ARCHITECTS

PrArch33056092




1 : 100

New Brick chimney to extend min. 1m beyond ex. roof sheeting. Walls to be plastered & painted to match existing

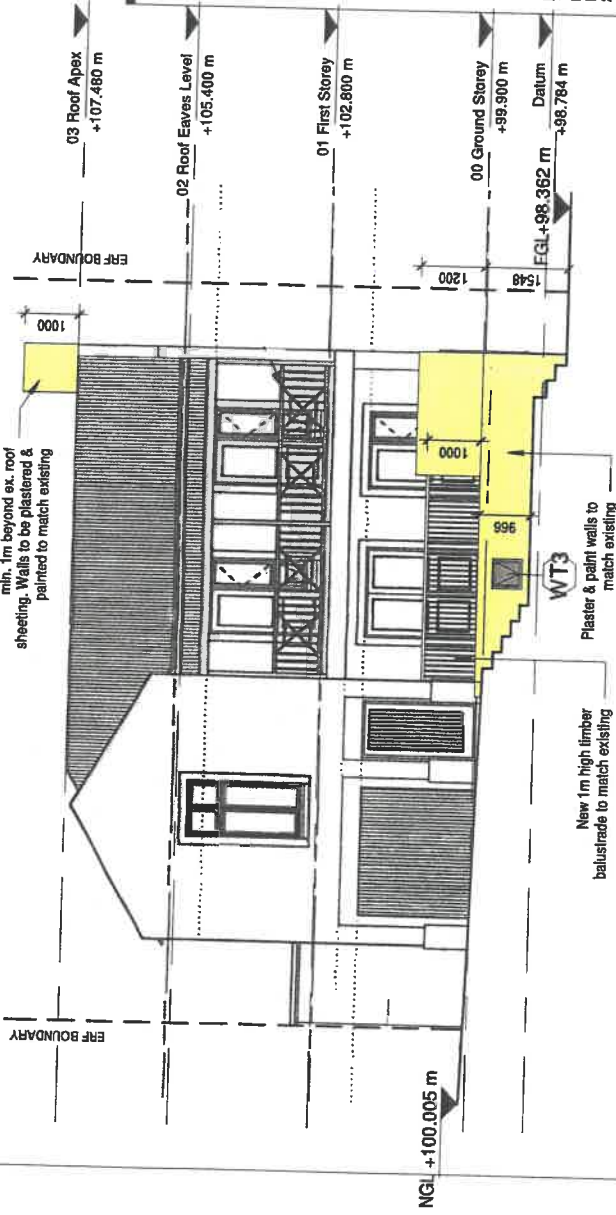

North Elevation
1 : 100

New Brick chimney to extend min. 1m beyond ex. roof sheeting. Walls to be plastered & painted to match existing

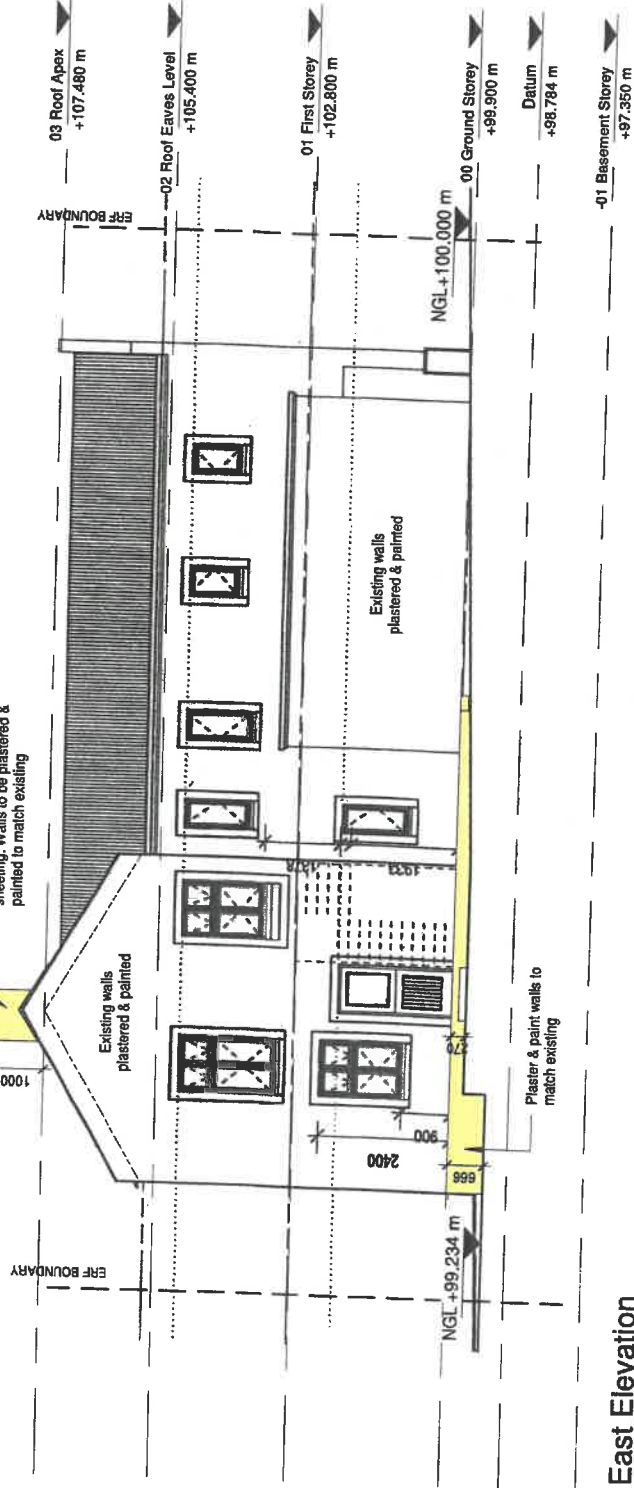

East Elevation
1 : 100

COUNCIL NOTES

- GENERAL:**
1. ALL WORK TO BE DONE IN ACCORDANCE WITH SANS 10400
 2. SANS 10400 TO BE SATISFIED PER MEANS SPECIFIED IN SCHEDULE A AND B, SANS 10400-A: FORM 1.
 3. DO NOT SCALE. REFER ONLY TO FIGURED DIMENSIONS.
 4. ALL LEVELS, DIMENSIONS, GRADIENTS AND STEPS TO BE CHECKED ON SITE PRIOR TO CONSTRUCTION AND ANY DISCREPANCIES TO BE REPORTED TO THE ARCHITECT IMMEDIATELY.
- STRUCTURAL DESIGN:**
- 3.F. NO STRUCTURAL ENGINEER HAS BEEN APPOINTED ACCORDING TO FORM 1. THE STRUCTURAL SYSTEM TO COMPLY WITH THE DETAIL REQUIREMENTS OF SANS 10400 PARTS 4, 5, 6, 99, 100.
 1. PROVIDE OF SANITARY FACILITIES DURING CONSTRUCTION TO COMPLY WITH THE DETAIL REQUIREMENTS OF SANS 10400-D. SUBMIT PROPOSAL TO THE ARCHITECT FOR APPROVAL.
 2. ALL FOUNDATIONS ACCORDING TO STRUCTURAL ENGINEER'S DESIGN UNLESS OTHERWISE SPECIFIED IN FORM 1.
 3. ALL DEEP FOOTINGS, SOIL RAFTS, COMPACTION AND SUB-SURFACE DRAINAGE ACCORDING TO CIVIL ENGINEER'S DETAILS UNLESS OTHERWISE SPECIFIED IN FORM 1.
 4. ALL CLAY MASONRY OR CONCRETE BLOCK WALLS TO BE CONSTRUCTED IN STANDARD SIZE CLAY BRICKS OR STANDARD SIZE CONCRETE BLOCKS.
- ROOFS:**
1. ROOF COVERINGS, WATERPROOFING SYSTEMS, AND FLAT ROOFS, GUTTERS AND DOWN PIPES TO COMPLY WITH THE DETAIL REQUIREMENTS OF SANS 10400-L AND SANS 10400-R UNLESS OTHERWISE SPECIFIED IN FORM 1.
 2. FIRE RESISTANCE AND COMBUSTIBILITY OF ROOF AND CEILING ASSEMBLY TO COMPLY WITH FIRE ENGINEER'S REQUIREMENTS UNLESS OTHERWISE SPECIFIED IN FORM 1.
 3. HEALTH & PUBLIC SAFETY:
- HEALTH & PUBLIC SAFETY:**
1. CHANGES IN LEVEL, RAMPS AND DRIVEWAYS, AND ACCESS TO SWIMMING POOLS TO COMPLY WITH SANS 10400-D. SUBMIT PROPOSAL TO THE ARCHITECT FOR APPROVAL.
 2. STAIRWAYS AND DISCONNECTING LOBBIES TO ALL TOILETS TO BE INDEPENDENTLY AND ADEQUATELY VENTILATED IN COMPLIANCE WITH SANS 10400-Q.
 3. THE MEANS FOR PROVIDING FACILITIES FOR PEOPLE WITH DISABILITIES IS IN ACCORDANCE WITH SANS 10400-S UNLESS OTHERWISE SPECIFIED IN FORM 1.
- DRAINAGE & STORMWATER:**
1. DRAINAGE SYSTEM TO COMPLY WITH THE DETAIL REQUIREMENTS OF SANS 10400-P UNLESS OTHERWISE SPECIFIED IN FORM 1.
 2. STORMWATER DISPOSAL TO COMPLY WITH THE DETAIL REQUIREMENTS OF SANS 10400-R UNLESS OTHERWISE SPECIFIED IN FORM 1.
- MATERIALS AND FINISHES:**
1. MATERIALS AND FINISHES AS INDICATED ON THE DRAWINGS, MATERIAL NOTES AND/OR FINISHES SCHEDULES
 2. MASONRY WALLS TO BE PLASTERED AND PAINTED UNLESS OTHERWISE SPECIFIED ON THE DRAWINGS.

WELGEVONDEN
ESTATE

ESTATE MANAGER
Gerrit Marx

ESTATE REVIEW ARCHITECT
Francine Mabin

DATE OF APPROVAL: July 2022

Client

Sarel Eisebeth

15/01/22

Project

10 Red Oak, Welgevonden

Drawing

North and East Elevations

Scale

1 : 100

Date

10/31/22

Drawn

LT

Project No.

Drawing No.

Project #

A103

Revision No.

C

LARYSSA PRINS ARCHITECTS

PrArch33056092

Rev	Description	Date
A	WHOA Submission	20220623
B	Drainage Section and Ceiling height	20221031
C	Drainage	20230728

COUNCIL NOTES

- GENERAL:
1. ALL WORK TO BE DONE IN ACCORDANCE WITH SANS 10400
 2. SANS 10400 TO BE SATISFIED PER MEANS SPECIFIED IN SCHEDULE A AND B, SANS 10400-A: FORM 1.
 3. DO NOT SCALE. REFER ONLY TO FIGURED DIMENSIONS.
 4. ALL LEVELS, DIMENSIONS, GRADIENTS AND STEPS TO BE CHECKED ON SITE PRIOR TO CONSTRUCTION AND ANY DISCREPANCIES TO BE REPORTED TO THE ARCHITECT IMMEDIATELY.
 5. STRUCTURAL DESIGN:
 6. 3. IF NO STRUCTURAL ENGINEER HAS BEEN APPOINTED ACCORDING TO FORM 1, THE STRUCTURAL SYSTEM TO COMPLY WITH THE DETAIL REQUIREMENTS OF SANS 10400 PARTS H, J, K, L, M AND N AND IN THE CASE OF THREE BUILDINGS WITH SANS 10082.
 7. SITE OPERATIONS:
 8. 1. PROVISION OF SANITARY FACILITIES DURING CONSTRUCTION TO COMPLY WITH THE DETAIL REQUIREMENTS OF SANS 10400-D. SUBMIT PROPOSAL TO THE ARCHITECT FOR APPROVAL.
 9. FOUNDATIONS:
 10. ALL FOUNDATIONS ACCORDING TO STRUCTURAL ENGINEER'S DESIGN UNLESS OTHERWISE SPECIFIED IN FORM 1.
 11. ALL DEEP FOOTINGS, SOIL RAFTS, COMPACTION AND SUB-SURFACE DRAINAGE ACCORDING TO CIVIL ENGINEER'S DETAILS UNLESS OTHERWISE SPECIFIED IN FORM 1.
 12. STRUCTURAL STRENGTH AND STABILITY OF WALLS TO STRUCTURAL ENGINEERS APPROVAL UNLESS OTHERWISE SPECIFIED IN FORM 1
 13. 2. ALL CLAY MASONRY TO BE CONSTRUCTED IN STANDARD SIZE CONCRETE BLOCKS.
 14. ROOFS:
 15. 1. ROOF COVERINGS, WATERPROOFING SYSTEMS, AND FLAT ROOFS, GUTTERS AND DOWN PIPES TO COMPLY WITH THE DETAIL REQUIREMENTS OF SANS 10400-L AND SANS 10400-R UNLESS OTHERWISE SPECIFIED IN FORM 1
 16. 2. FIRE RESISTANCE AND COMBUSTIBILITY OF ROOF AND CEILING ASSEMBLY TO COMPLY WITH FIRE ENGINEER'S REQUIREMENTS UNLESS OTHERWISE SPECIFIED IN FORM 1
 17. HEALTH & PUBLIC SAFETY:
 18. 1. CHANGES IN LEVEL, RAMPS AND DRIVEWAYS, AND ACCESS TO SWIMMING POOLS TO COMPLY WITH SANS THE DETAIL REQUIREMENTS OF SANS 10400-D UNLESS OTHERWISE SPECIFIED IN FORM 1
 19. 2. STORMWATER DISPOSAL TO COMPLY WITH THE DETAIL REQUIREMENTS OF SANS 10400-P UNLESS OTHERWISE SPECIFIED IN FORM 1
 20. MATERIALS AND FINISHES:
 21. 1. MATERIALS AND FINISHES AS INDICATED ON THE DRAWINGS. MATERIAL NOTES AND/OR FINISHES SCHEDULES
 22. MASONRY WALLS TO BE PLASTERED AND PAINTED UNLESS OTHERWISE SPECIFIED ON THE DRAWINGS.

Client

Sarel Eisebeth

Project

10 Red Oak, Welgevonden


15/07/22

Drawing


South and West Elevations

Scale	Size	Date	Drawn
1 : 100	A104	10/31/22	LT

Project No.	Drawing No.	Revision No.
A104	A104	C

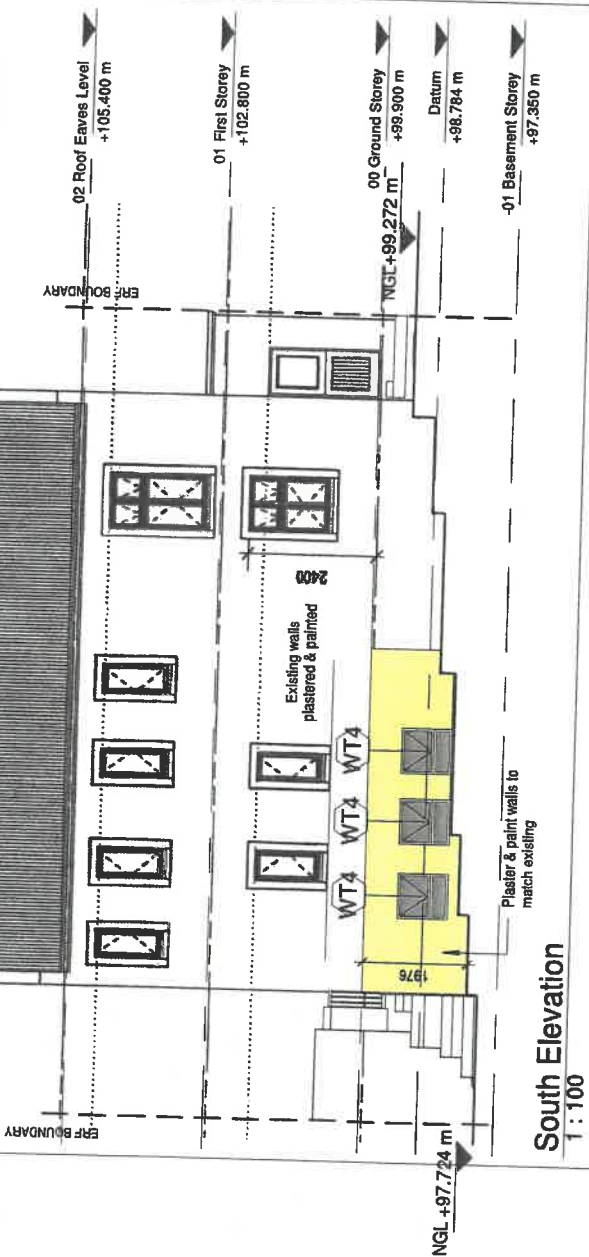

South Elevation
1 : 100

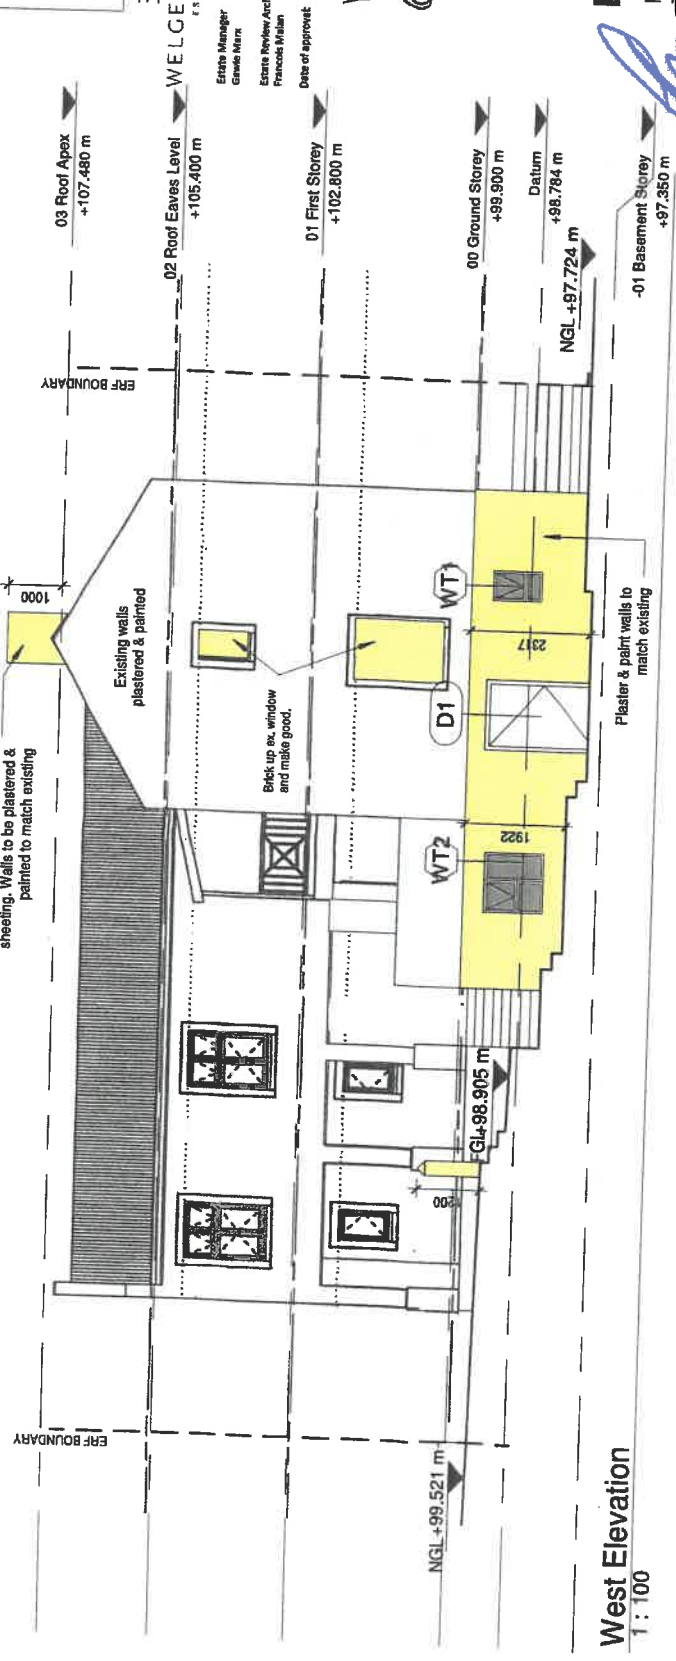

West Elevation
1 : 100

ESTATE

WELGEVONDEN

Estate Manager

Gracie Mark

Estate Review Architect

Francisco Mullan

Date of approval

July 2022