



STELLENBOSCH

STELLENBOSCH • PNIEL • FRANSCHHOEK

MUNISIPALITEIT • UMASIPALA • MUNICIPALITY

Application Number: TP1281/2025

Our File Reference Number: Erf 2156, Stellenbosch

Your Reference Number: None

Enquiries: Ulrich von Molendorff

Contact No: 021 – 808 8682

Email address: Ulrich.Vonmolendorff@stellenbosch.gov.za

PER E-M

Sir / Madam

APPLICATION FOR CONSENT USE: ERF 2156, STELLENBOSCH

1. The above application refers.
2. The duly authorised decision maker has decided on the above application as follows:
3. That the application in terms of Section 15(2)(o) of the Stellenbosch Municipal Land Use Planning Bylaw, 2023, for a **Consent Use** to allow for the utilization of the existing dwelling house for purposes of a commune;

BE APPROVED in terms of Section 60 of the said Bylaw.

4. The approval is subject to the following **conditions** imposed in terms of Section 66 of said Bylaw:
 - 4.1 The approval only applies to the proposal under consideration and shall not be construed as authority to depart from any other legal prescriptions or requirements from Council or other legislation or Bylaws or Regulations that may be applicable.
 - 4.2 The development must be implemented generally in accordance with the drawings referenced as **Site Plan, Section – PP31/23(1) – Rev 4, dated August 2025; and Ground Floor Plan and Elevation – PP31/23(2) – Rev 5, dated November 2025, and drawn by PretPlan, attached as ANNEXURE B.**
 - 4.3 The approval granted shall not exempt the applicant from complying with any other legal prescriptions or requirements that might have a bearing on the proposed use.
 - 4.4 A maximum of eight (8) persons may be accommodated in the commune.

- 4.5 The conditions imposed by the **Directorate: Infrastructure Services** as contained in their memo dated 05 September 2025, attached as **ANNEXURE E**, be complied with.
- 4.6 The conditions imposed by **Manager: Electrical Services** as contained in their memo dated 16 October 2025, attached as **ANNEXURE F**, be complied with.
- 4.7 No vehicles of the residents or visitors to the property may be parked in the street at any time.
- 4.8 Sufficient on-site parking must be provided in accordance with the provisions of the applicable Zoning Scheme Bylaw and as illustrated on the attached site plan, to the satisfaction of the Municipality.
- 4.9 The land use to not create any undue noise or be a nuisance to the neighbourhood and that precautionary measures be taken to avoid environmental noise pollution in terms of the Western Cape Noise Control Regulations, 2013, PN. 200/2013 made in terms of Section 25 of the Environmental Conservation Act, 1989 (Act No. 73 of 1989).
- 4.10 A detailed landscaping plan to soften the parking area and maintain the residential character of the streetscape be submitted to and approved by the Municipality as part of the building plan.
- 4.11 Building plans be submitted for all changes of use in the existing buildings and which building plan(s) be approved and related occupancy certificates be issued prior to the vesting of any of the related approvals.

5. The reasons for the above decision are as follows:

- 5.1 The residential character of the area will not be impacted on by the proposed use as the primary use of the property will still be residential.
- 5.2 The proposal would also be of an appropriate scale that would relate to the surrounding townscape and land use character of the area.
- 5.3 The anticipated impacts relating to parking, landscaping and the streetscape can be satisfactorily mitigated through the conditions of approval.
- 5.4 Adequate onsite parking has been provided for the proposed use.

6. **Matters to be noted:**

6.1 Should, after following due process –


- a) The subject approved land use remains in breach of complying with any of the conditions of approval required for the vesting of the subject approval, and/ or*
- b) The operational use be in breach of any of the conditions of approval, inclusive of persistent complaints of undue noise levels, and/ or*
- c) The property be used for any unauthorised uses not permitted in terms of this approval,*

the authorised official of the Municipality will exercise its discretion in terms of Section 90(c) of the Municipal Land Use Planning By-Law to withdraw the subject approval granted and the building structures to be reverted to uses in line with the primary use of the property.

- 7. You are hereby informed in terms of section 79(2) of the Stellenbosch Municipal Land Use Planning Bylaw of your right to appeal the above decision to the Appeal Authority within 21 days from the date of notification of the above decision. Please note that no late appeals or an extension of time for the submission of appeals are permitted in terms of Section 80(1)(a) of the said By-Law.
- 8. Appeals must be submitted by completing the required form with the prescribed information to satisfy the requirements of Section 80(2) of the said By-law, failing which the appeal will be invalid in terms of Section 81(1)(b) of the said By-Law.
- 9. **Appeals must be addressed to the Municipal Manager and submitted to his/ her designated official by means of e-mail at the following address: landuse.appeals@stellenbosch.gov.za**
- 10. Any party (applicant or other) who lodges an appeal must pay the applicable appeal fee in terms of the approved municipal tariffs and submit the proof of payment together with the appeal. The **LU** Reference number on this correspondence, or the applicable Erf/ Farm Number must be used as the reference for the payment of the appeal fee.
- 11. The appeal form and approved tariff structure and the banking details for the General Account can be accessed and viewed on the municipal website. For any enquiries the office can be contacted at landuse.appeals@stellenbosch.gov.za or 021 – 808 8684.

12. An applicant who lodges an appeal must also adhere to the following requirements stipulated in terms of section 80(3) to (7) of the said By-law:
- (a) Simultaneously serve the appeal on any person who commented on the application concerned and any other person as the municipality may determine.
 - (b) The notice by the applicant must invite persons to comment on the appeal within 21 days from date of notification of the appeal.
 - (c) The notice must be served in accordance with section 35 of the said legislation and in accordance with the prescripts or such additional requirements as may be determined by the Municipality.
 - (d) Proof of serving the notification must be submitted to the Municipality at the above E-mail address within 14 days of serving the notification.
13. Kindly note that no appeal right exists in terms of Section 62 of the Local Government Municipal Systems Act, No 32 of 2000.
14. Kindly note the above decision in the case of any approval, is suspended, and may therefore not be acted on, until such time as the period for lodging appeals has lapsed, any appeal has been finalised, and you've been advised accordingly.


Yours faithfully

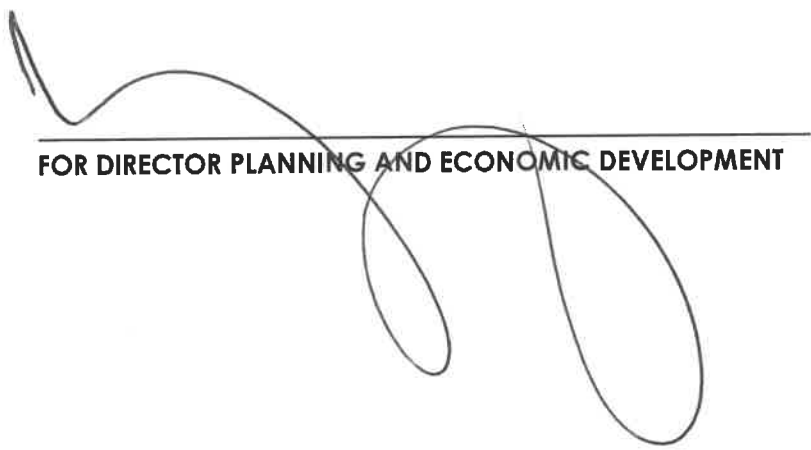

FOR DIRECTOR PLANNING AND ECONOMIC DEVELOPMENT

17/8/2026.
DATE

COPIES TO OBJECTORS

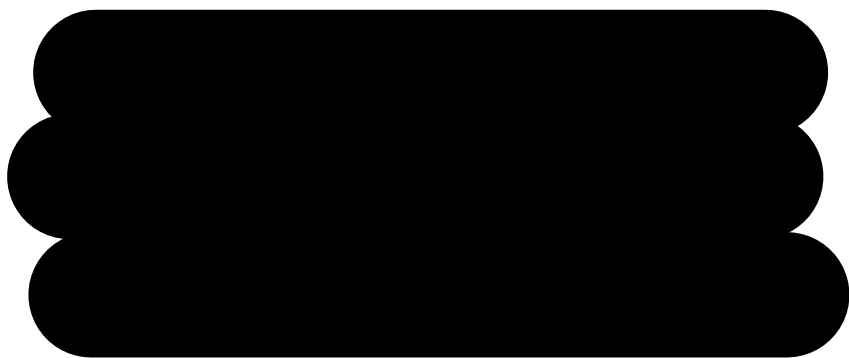

ANNEXURE B

APPLICATION FOR A CONSENT USE: ERF 2156, STELLENBOSCH

SITE DEVELOPMENT PLAN/SITE PLAN

Electrical Savings

Thermal Insulating as per SANS 10400XA-ED2
All hot water service pipes to be clad with
insulation with min. R - Value of 1. Total hot water
demand 115 - 140 litres/capita/d with storage
volume at 60-50 litres/capita and 2-5 kw/unit

Occupation Classification
Climate Zone
Building Orientation
Floor Construction
External Wall Construction
New Doors and Windows
Internal Areas
See Fenestration Notes
Calculation done using low E

H4
4 North / South
Contc. slab

270 mm masonry wall plastered both sides
Epoxy coated alum. and glass frames
69, 280 sq.m. Ground Floor Plan
Not to exceed allowable 15% of net area
Assuming emissivity of 0.2 or better
To achieve min. insulation total R value of
3.7 for climate zone 4 as per SANS 10400-XA
(clause 4.4.5) and must comply with SANS
10400 T and SANS 10400 W.


Roof sheeting R - value 0.03
Insulation R - value 3.35
Ceiling R - value 0.05
Total R - value 3.70

Fenestration Calculation


Typical conductance co-efficients - Table F1
Internal Floor Areas 69, 280 sq.m.
W1 - 1.8 x 1.2 x 3 = 6.48 sq.m.
W2 - 0.6 x 0.9 x 3 = 1.62 sq.m.
D1 - 0.6 x 2.1 x 2 = 2.52 sq.m.
Total = 10.62 sq.m.
10.62 sq.m + 69,280 sq.m. = 15 %
Hot water supply in accordance with
SANS 10400XA41.

Water Supply Installations

West Elevation
1 : 100

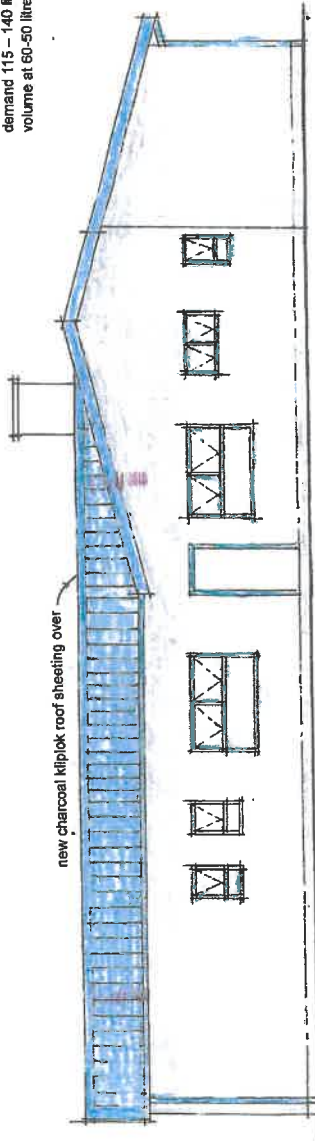


new charcoal kliplok roof sheeting over

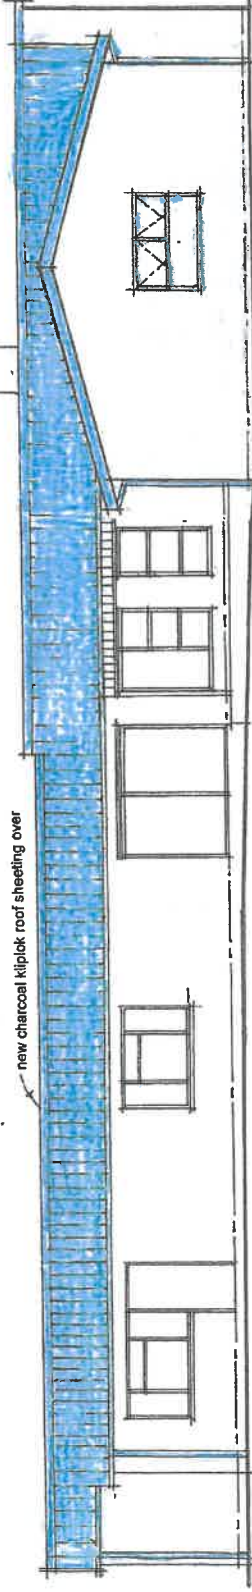

North Elevation
1 : 100

new charcoal kliplok roof sheeting over

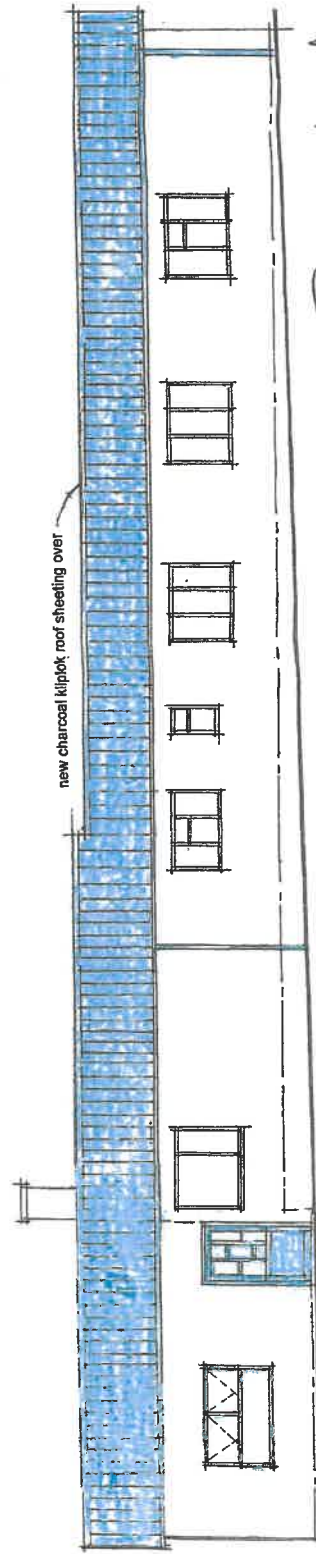

South Elevation
1 : 100

pretplan
BOUWERIGHEID

Project

Calypso Ventures

Proposed Additions to Exist.
Dwelling on Erf 2156,
118 Merriman Ave.
Simonswyk,
Stellenbosch

Sheet Description:

'As Built' Roof Plan Elevations

Project number	PP1104/19
Scale	1 : 100
Date	Sept. 2020
Drawn by	botha
Rev	2 - May 2025

[Signature]
Owner Erf 2156
SACAP ST1950

Ceilings.
6,4 mm Rhinoboard ceiling crestone
skimmed and fixed to underside of
38 x 38 branding at 400 mm centres.

Insulation.
Provide 410 Sisalation under roof sheats
and 150mm Isotherm on ceiling.

Fascias.
Everite 228 x 12 fibre cement fascias.

Roof Construction.
New Additions.
0,8 mm charcoal kliploek roof sheeting on
70 x 50 purlins at 1000 mm centres on
150 x 50 beams at 1000 mm centres with
38 mm gable hoop iron anchors at beam
centres built across. 4 to 5 layers into new
brickwork and tied around wall ties and
beams on 114 x 38 wall ties on wall plate.
Pitch to be 15 degree match exist. flat roof.

Walls.
270 mm cavity walls built with clay face
bricks matching existing layered in stretcher
bond in 1 : 5 cement mortar with wall ties
and brickwork to every course. Plastered
and painted with 1 layer under coat and
2 coats Plascon wall and all internally.

Foundations.
All foundations to comply to SANS
10400 Part H and K and 850 x 250
for load bearing walls.

Floor Construction.
Ceramic floor tiles as per clients choice
on 25 mm cement screed on 100 mm
concrete slab of min. 15 Mpa concrete
strengthened on 250 micron OPC membrane
on 50 mm sand bed on well compacted
non - organic earth fill material.

Section A - A
1 : 100

Areas :

Erf 2156	119,00 sq.m.
Exist. Dwelling	237,40 sq.m.
New Additions	102,20 sq.m.
Total	344,60 sq.m.
Footprint	344,60 sq.m.
Coverage	30,7 %




Calipso Ventures
Proposed Additions to Exist.
Dwelling on Erf 2156,
118 Merriman Ave.
Simonswyk,
Stellenbosch

Sheet Description

'As Built' Roof Plan
Site Plan,
Section

Project number	PP31/23
Scale	1 : 100, 1 : 200
Date	June 2023
Drawn by	botha
Rev-A	Aug. 2025

[Signature]
Owner Erf 2156
SACAP ST1950

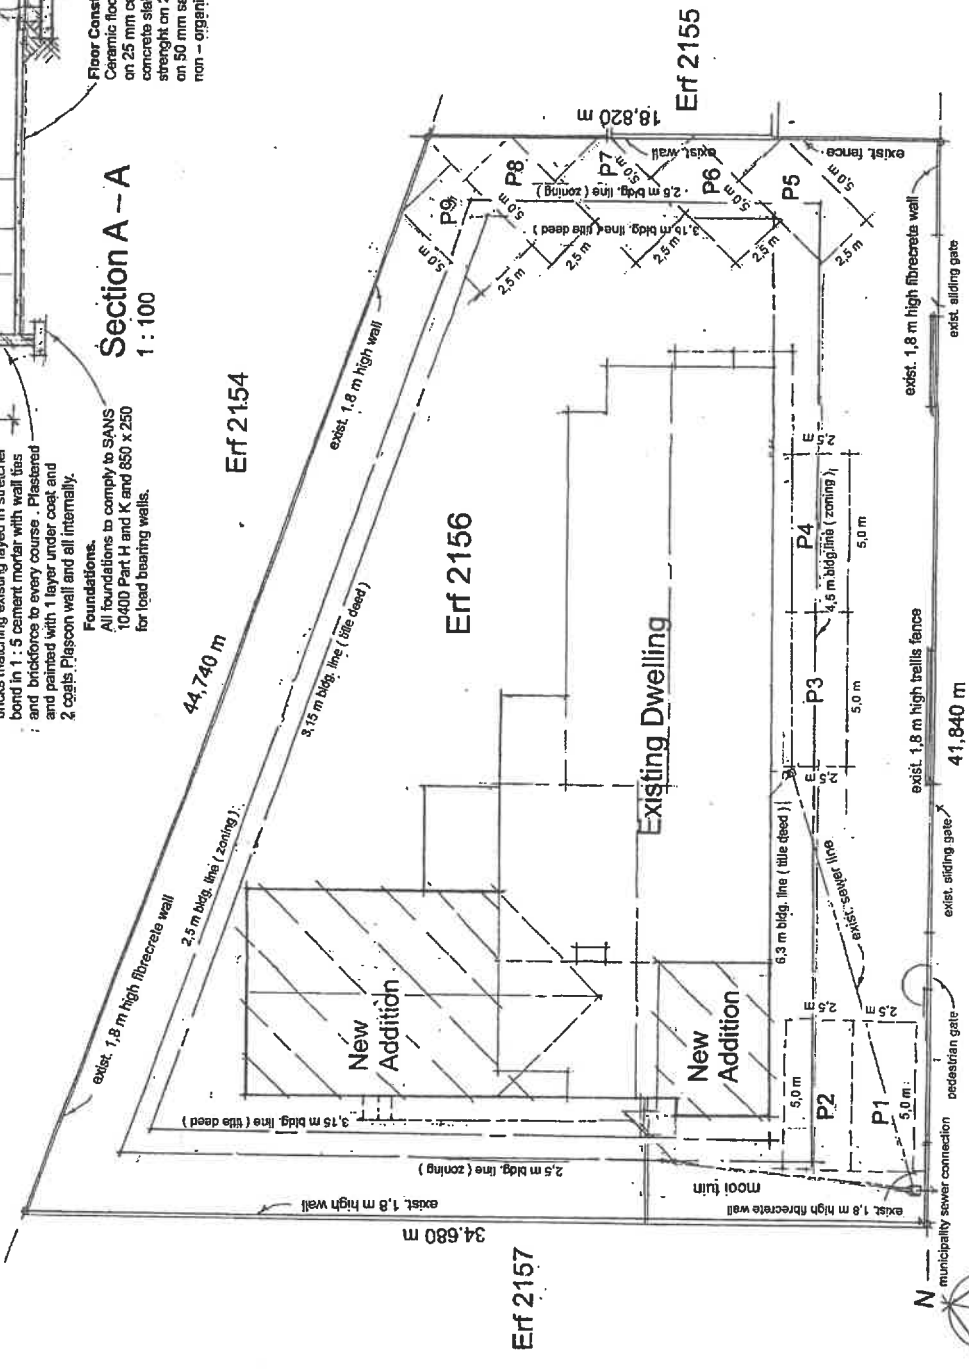

Site Plan
1 : 200

Merriman Avenue

Notes :

Roof Construction:

New Roof Over Existing:
 0,6 mm charcoal kliplok roof sheeting on
 70 x 50 purlins at 1000 mm centres on
 150 x 50 beams at 1000 mm centres with
 38 mm girt, roof iron anchors at beam
 centres built approx. 4 to 5 layers into new
 brickwork and tied around wall ties and
 beams on 114 x 38 wall ties on wall plate.
 Pitch to be 15 degree match exist. roof.
Fascias:
 Everite 228 x 12 fibre cement fascias.
Insulation:
 Provide 410 Sisalation under roof sheets
 and 150mm Isotherm on ceiling.
Ceilings:
 6,4 mm Rhinoboard ceiling crestone
 skimmed and fixed to underside of
 .8 x 38 bridleing at 400 mm centres.

new charcoal kliplok roof sheeting over

Windows:

All windows to be epoxy coated
 aluminium with 6,4 mm safety glass
 if size is larger than 1 m square.
 Colour as per clients choice.
 W1 - 1800 x 1200 top hung window
 W2 - 600 x 900 top hung open out
 W3 - 1500 x 400 fixed panel window.

Doors:

D1 - 1800 x 2100 alum. and glass
 sliding door with 6,4 mm safety
 glass in alum. frame matching exist.
 D2 - 813 x 2032 x 40 mm semi-solid
 door ready for painting
 D3 - 813 x 2032 x 40 mm semi- solid
 sliding door ready for painting
 D4 - 800 x 2100 aluminium epoxy
 coated wif 6,4 mm safety glass and
 security gate.

Walls:

270 mm cavity walls built with clay face
 bricks matching existing laved in stretcher
 bond in 1 : 5 cement mortar with wall ties
 and brickwork to every course. Plastered
 and painted with 1 layer under coat and
 2 coats Plascon wall and all internally.
Floor Construction:
 Ceramic floor tiles as per clients choice
 on 25 mm cement screed on 100 mm
 concrete slab of min. 15 Mpa concrete
 straight on 250 micron DPC membrane
 on 50 mm sand bed on well compacted
 non - organic earth fill material.
 Concrete slabs and beams.
 To comply to SANS10400 - B, Part J.H.
 K.L.M.N of SANS 10400 Concrete slab
 & beams to be designed and approved
 by struct. engineer as per SABS 0162.
Foundations:
 All foundations to comply to SANS
 10400 Part H and K and 850 x 250
 for load bearing walls.

Areas :

Erf 2156 1119,00 sq.m.
 Exist. Dwelling 237,40 sq.m.
 New Roof over 102,20 sq.m.
 Total 344,60 sq.m.
 Footprint 344,60 sq.m.
 Coverage 30,7 %



Calipso Ventures


Proposed New Roof over Exist.
 Dwelling on Erf 2156,
 118 Merriman Ave.
 Simonswyk,
 Stellenbosch

Sheet Description:

'As Built' Roof Plan
 Ground Floor Plan
 and Elevation

Project number	PP31/23	Scale	1 : 100
	2	Date	June 2023
Rev. 5 - Nov. 2025		Drawn by	botha

[Signature]
 Owner Erf 2156
 SACAP ST1950

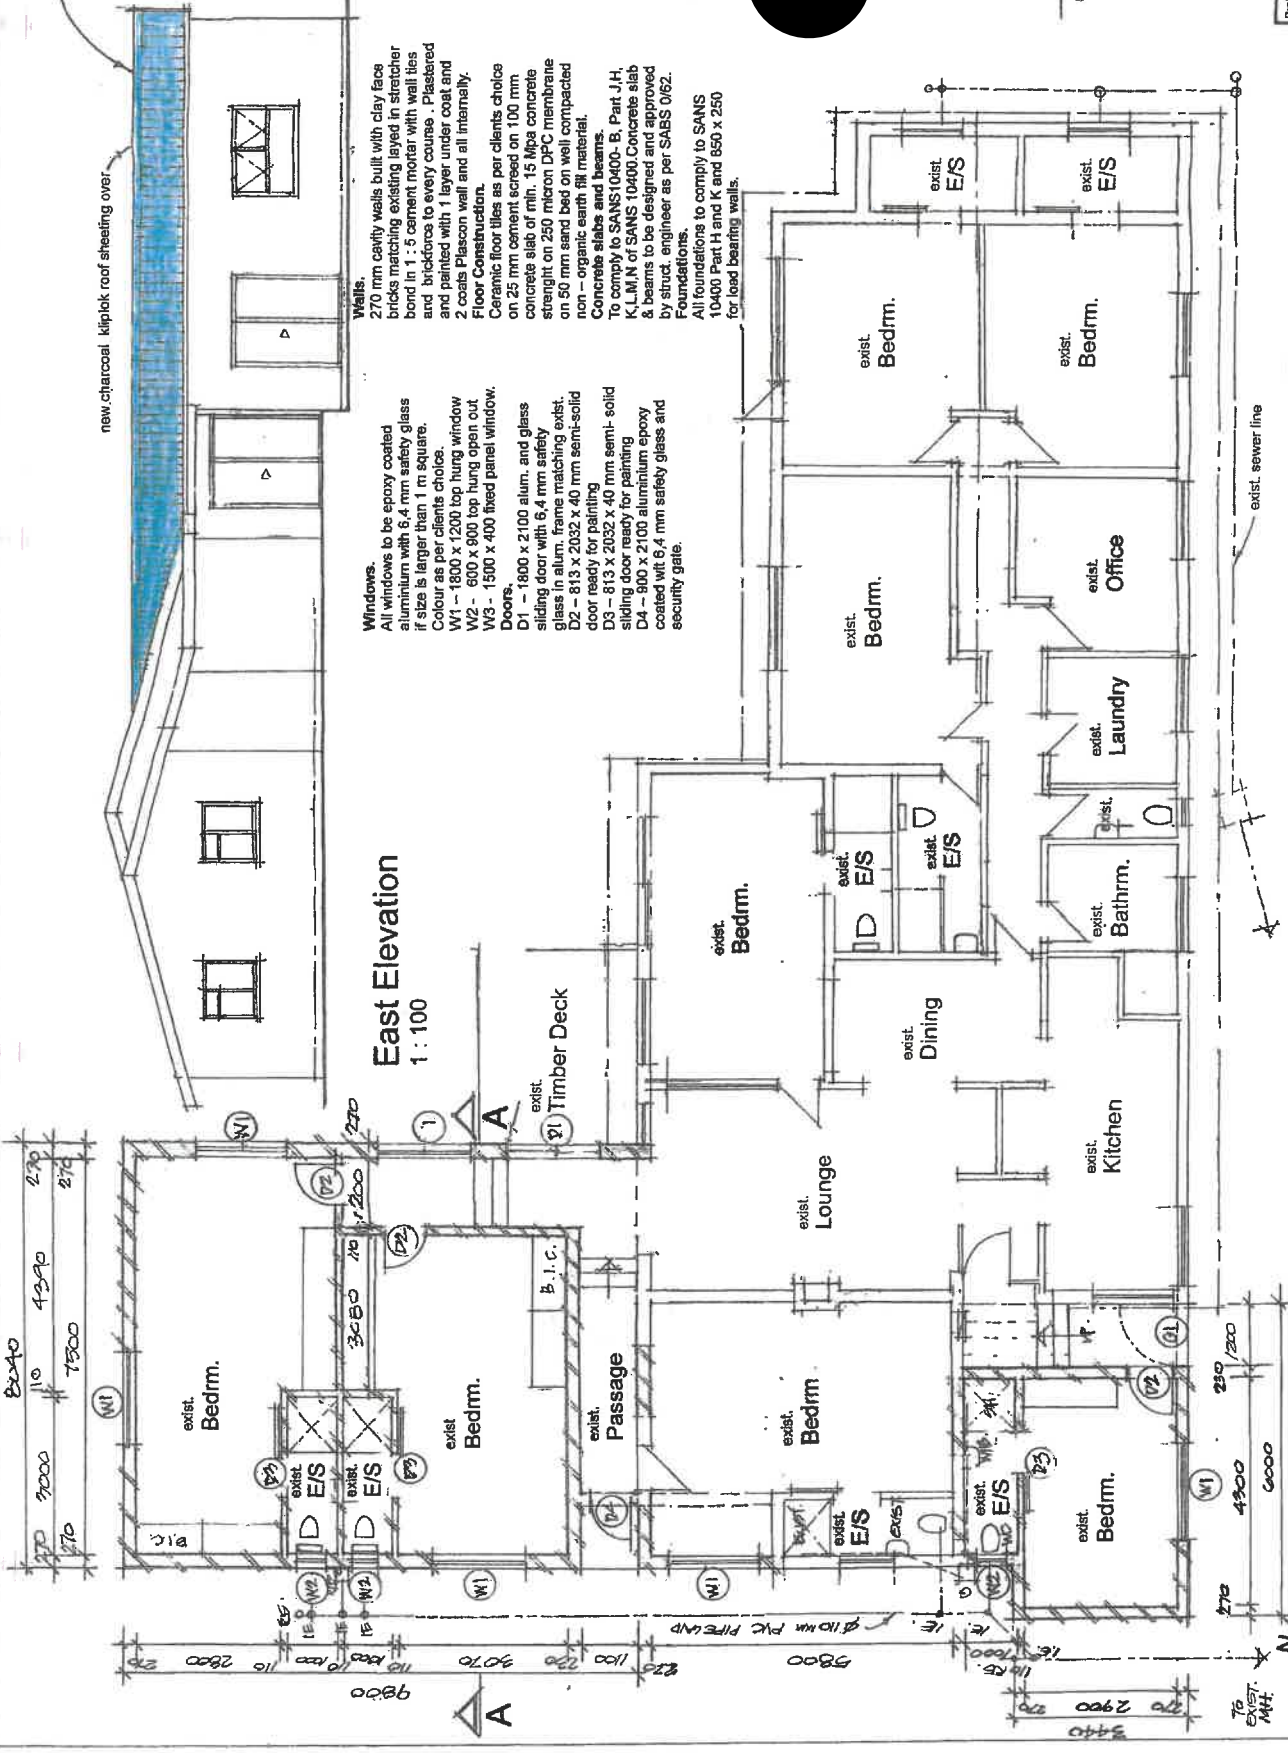

Ground Floor Plan
 1 : 100



ANNEXURE E

APPLICATION FOR A CONSENT USE: ERF 2156, STELLENBOSCH

COMMENT FROM THE DIRECTORATE:
INFRASTRUCTURE SERVICES



STELLENBOSCH MUNICIPALITY
STELLENBOSCH · PNIEL · FRANSCHHOEK

MEMORANDUM

DIREKTORAAT: INFRASTRUKTUURDIENSTE
DIRECTORATE: INFRASTRUCTURE SERVICES

CIVIL ENGINEERING SERVICES

To ▫ Aan: Director: Planning + Economic Development
Att Aandag: Nicole Katts
From ▫ Van: Development (Infrastructure Services)
Author ▫ Skrywer: Xolani Tika
Date ▫ Datum: 05 September 2025
Our Ref ▫ Ons Verw: Civil LU 2965
Town Planning Ref: TP1281/2025
Re ▫ Insake: Erf 2156, Stellenbosch: The application is made in terms of Section 15(2)(o) of the Stellenbosch Municipal Land Use Planning By-Law for a Consent Use to allow for the utilization of the existing 8-bedroom dwelling house for a commune on Erf 2156, Stellenbosch.


The application is recommended for approval, subject to the following conditions:

1. Development Charges (DCs)

- 1.1 The following DC's are payable: See **Development Charge Calculation** attached. Please note that this calculation is indicative at this stage. The final calculations will be determined at the building plan stage submission.
- 1.2 The DC's were calculated by using the 2025/2026 tariff structure. If DC's are paid after 30 June 2026 it will have to be recalculated by using the tariff structure and DC Policy principles applicable at date of payment.
- 1.3 The appropriate DC's are payable before building plan approval

2. Parking area

- 2.1 The parking area and dimensions must be indicated on the building plan at building stage submission and it must meet the minimum parking bay requirements as per the municipal zoning scheme.

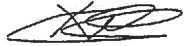**Xolani Tika****Technician: Development (Infrastructure Services)**

T:\2.0 DEVELOPMENT\01 Land Use applications\2965 (XT) Erf 2156 Stellenbosch (TP1281-2025)\2965 () Erf 2156 Stellenbosch (TP1281-2025).doc

KTitus



Stellenbosch Municipality

Development Charge Calculation



APPLICATION INFORMATION	
Application Number:	DC 2985 (XT) Erf 2156 - Stellenbosch (TP1281-2025)
Development Name:	
Date:	05 September 2025
Financial Year:	2025/2026
Erf Location (Select from 7 Locations):	Stellenbosch Town
School/ECD Category (Select Quintile 1-4 or 5 or N/A)	N/A
Erf Region (Select Urban or Rural):	Urban
Erf No. / Farm No.:	2156
DC Parameters Reference:	Convert existing 8-bedroom house into a commune_SDP drawing no: PP31/23 Rev 4 dated 2025/08/ by Preplan Building Plans Botha Pretorius

SUMMARY OF DC CALCULATION									
Service:	Water	Sewer	Stormwater	Solid Waste	Roads & Transport	Sub Total (Civil Eng Services)	Community	Totals	
Unit(s):	kl/day	kl/day	ha°C	t/week	trips/day		persons		
Total Increased Services Usage:	0.54	0.45	0.012	0.045	3.75		3		
Total Service Usage Reduction:	0	0	0	0	0.0		0		
Total Service Usage after Reduction:	0.54	0.45	0.01200	0.045	3.8		3		
Charges before adjusting for positive only, before Deductions	R 18 321,49	R 16 804,07	R 2 691,53	R 4 765,43	R 24 503,30	R 67 085,82	R 12 529,53	R	79 615,35
Charges adjusted for positive only, before Deductions	R 18 321,49	R 16 804,07	R 2 691,53	R 4 765,43	R 24 503,30	R 67 085,82	R 12 529,53	R	79 615,35
Total Deductions:	R -	R -	R -	R -	R -	R -	R -	R	-
Total Development Charges Payable (excluding VAT):	R 18 321,49	R 16 804,07	R 2 691,53	R 4 765,43	R 24 503,30	R 67 085,82	R 12 529,53	R	79 615,35
VAT:	R 2 748,22	R 2 520,61	R 403,73	R 714,81	R 3 675,50	R 10 062,87	R 1 879,43	R	11 942,30
Total Development Charges Payable (including VAT):	R 21 069,72	R 19 324,68	R 3 095,26	R 5 480,24	R 28 178,80	R 77 148,69	R 14 408,96	R	91 557,65

APPLICANT INFORMATION	
Application Processed by:	Xolani Tika
Signature:	
Notes:	See the attached SDP

K.Titius

Stellenbosch Town

Land Use Category	Unit Type		Existing Usage			Proposed New Usage			Increase Usage		Development Charge Level (Oct/May)						Totals								
	Description	Unit	Area (ha)	Unit/Amount	Footprint	Area (m2)	Unit/Amount	Footprint	Amount	Year	Street	Stormwater	Solid Waste	Roads & Transport	Sub-Total (Civil Eng Services)	Community									
Residential	Single Residential >100m2	du							0	R	-	R	-	R	-	R	-								
	Single Residential >500m2	du							0	R	-	R	-	R	-	R	-								
	Single Residential >250m2	du							0	R	-	R	-	R	-	R	-								
	Single Residential <250m2	du							0	R	-	R	-	R	-	R	-								
	Second Dwelling	du							0	R	-	R	-	R	-	R	-								
	Less Formal Residential	du							0	R	-	R	-	R	-	R	-								
	Group Residential	du							0	R	-	R	-	R	-	R	-								
	Apartments	du							0	R	-	R	-	R	-	R	-								
	Retirement Village	du							0	R	-	R	-	R	-	R	-								
	Old age home	du							0	R	-	R	-	R	-	R	-								
Accommodation	Student Accommodation/Communal-Hotels	rooms					3																		
	Guest House	rooms							3	R	18 321.48	R	16 804.07	R	2 091.53	R	4 765.43	R	24 503.30	R	87 065.82	R	12 505.53	R	79 615.35
Commercial	Hotel, Residential	rooms							0	R	-	R	-	R	-	R	-								
	General Business	m2 GLA							0	R	-	R	-	R	-	R	-								
	Office	m2 GLA							0	R	-	R	-	R	-	R	-								
	Retail/Shop	m2 GLA							0	R	-	R	-	R	-	R	-								
	Restaurant	m2 GLA							0	R	-	R	-	R	-	R	-								
	Outdoor Function / Picnic Area	persons							0	R	-	R	-	R	-	R	-								
	Farm Market	stall							0	R	-	R	-	R	-	R	-								
	Conference Facility/Place of assembly	m2 GLA							0	R	-	R	-	R	-	R	-								
	Hospital/Clinic/Medical Rooms	m2 GLA							0	R	-	R	-	R	-	R	-								
	University/College	student							0	R	-	R	-	R	-	R	-								
Industrial	School/Day Care	student							0	R	-	R	-	R	-	R	-								
	Industrial - light	m2 GLA							0	R	-	R	-	R	-	R	-								
Industrial	Industrial - heavy	m2 GLA							0	R	-	R	-	R	-	R	-								
	Warehousing/Light Manufacturing	m2 GLA							0	R	-	R	-	R	-	R	-								
Non demand	Storage Facilities	unit							0	R	-	R	-	R	-	R	-								
	Open Space/Natural Environment/Utility Site	ha							0	R	-	R	-	R	-	R	-								
Other	Roads and Parking	ha							0	R	-	R	-	R	-	R	-								
	To be calculated (Based on equivalent demands)	n/a							0.0000	R	-	R	-	R	-	R	-								
Other		n/a							0.0000	R	-	R	-	R	-	R	-								
		n/a							0	R	-	R	-	R	-	R	-								
	Total Area:	0							0																

Charges before adjusting for positive only, before Deductions

Deduct	R	18 321.49	R	16 804.07	R	2 691.53	R	4 765.43	R	24 503.30	R	67 085.62	R	12 525.53	R	79 615.35
Charges adjusted for positive only, before Deductions	R	18 321.49	R	16 804.07	R	2 691.53	R	4 765.43	R	24 503.30	R	67 085.62	R	12 525.53	R	79 615.35
Deductions per service (from usage reductions)	R	18 321.49	R	16 804.07	R	2 691.53	R	4 765.43	R	24 503.30	R	67 085.62	R	12 525.53	R	79 615.35
Discount Deduction (%)	R	-	R	-	R	-	R	-	R	-	R	-	R	-	R	-
Additional Deduction per service - from Service Agreement (eum)	R	-	R	-	R	-	R	-	R	-	R	-	R	-	R	-
Sub Total after Adjustments and Deductions (excluding VAT)	R	-	R	-	R	-	R	-	R	-	R	-	R	-	R	-
VAT	R	18 321.49	R	16 804.07	R	2 691.53	R	4 765.43	R	24 503.30	R	67 085.62	R	12 525.53	R	79 615.35
Total Development Charges	R	2 748.22	R	2 520.61	R	403.73	R	774.61	R	3 675.50	R	10 062.87	R	1 979.3	R	11 842.39
	R	21 059.72	R	19 324.68	R	3 095.26	R	5 480.24	R	28 178.80	R	77 148.69	R	14 406.46	R	91 557.65

Ceilings.
6.4 mm Rhinoboard ceiling on stone
skimmed and fixed to underside of
38 x 38 bracing at 400 mm centres.

Insulation.
Provide 410 Silestone under roof sheets
and 150mm Isotherm on ceiling.

Fascias.
Everite 228 x 12 fibre cement fascias.

Walls.
270 mm cavity walls built with clay face
bricks matching existing in stretcher
bond in 1 : 5 cement mortar with wall ties
and brickwork to every course. Plastered
and painted with 1 layer under coat and
2 coats Flacon wall and all internally.

Foundations.
All foundations to comply to SANS
10400 Part H and K and 850 x 250
for load bearing walls.

Section A - A
1 : 100

Floor Construction.
Ceramic floor tiles as per clients choice
on 25 mm cement screed on 100 mm
concrete slab of min. 15 Mpa concrete
strengthened on 250 micron DPC membrane
on 50 mm sand bed on well compacted
non - organic earth fill material.

Roof Construction.
New Additions.
0.6 mm charcoal liplok roof sheeting on
70 x 50 purlins at 1000 mm centres on
150 x 50 beams at 1000 mm centres with
38 mm galv. hoop iron anchors at beam
centres built approx. 4 to 5 layers into new
brickwork and tied around wall ties and
beams on 114 x 38 wall ties on wall plate.
Pitch to be 15 degree match exist. flat roof.

Areas :
Erf 2156 1119,00 sq.m.
Exist Dwelling 237,40 sq.m.
New Additions 102,20 sq.m.
Total 344,60 sq.m.
Footprint 344,60 sq.m.
Coverage 30,7 %

pretplan
BOUFGIGENNE
BUILDING PLANS

Calipso Ventures
Proposed Additions to Exist.
Dwelling on Erf 2156,
118 Merriman Ave.
Simonswyk,
Stellenbosch


Sheet Description:

'As Built' Roof Plan
Site Plan,
Section

Project number	PP31/23
Scale	1 : 100, 1 : 200
Date	June 2023
Drawn by	botha
Rev'd - Aug. 2025	

SACAP ST1950

Owner Erf 2156

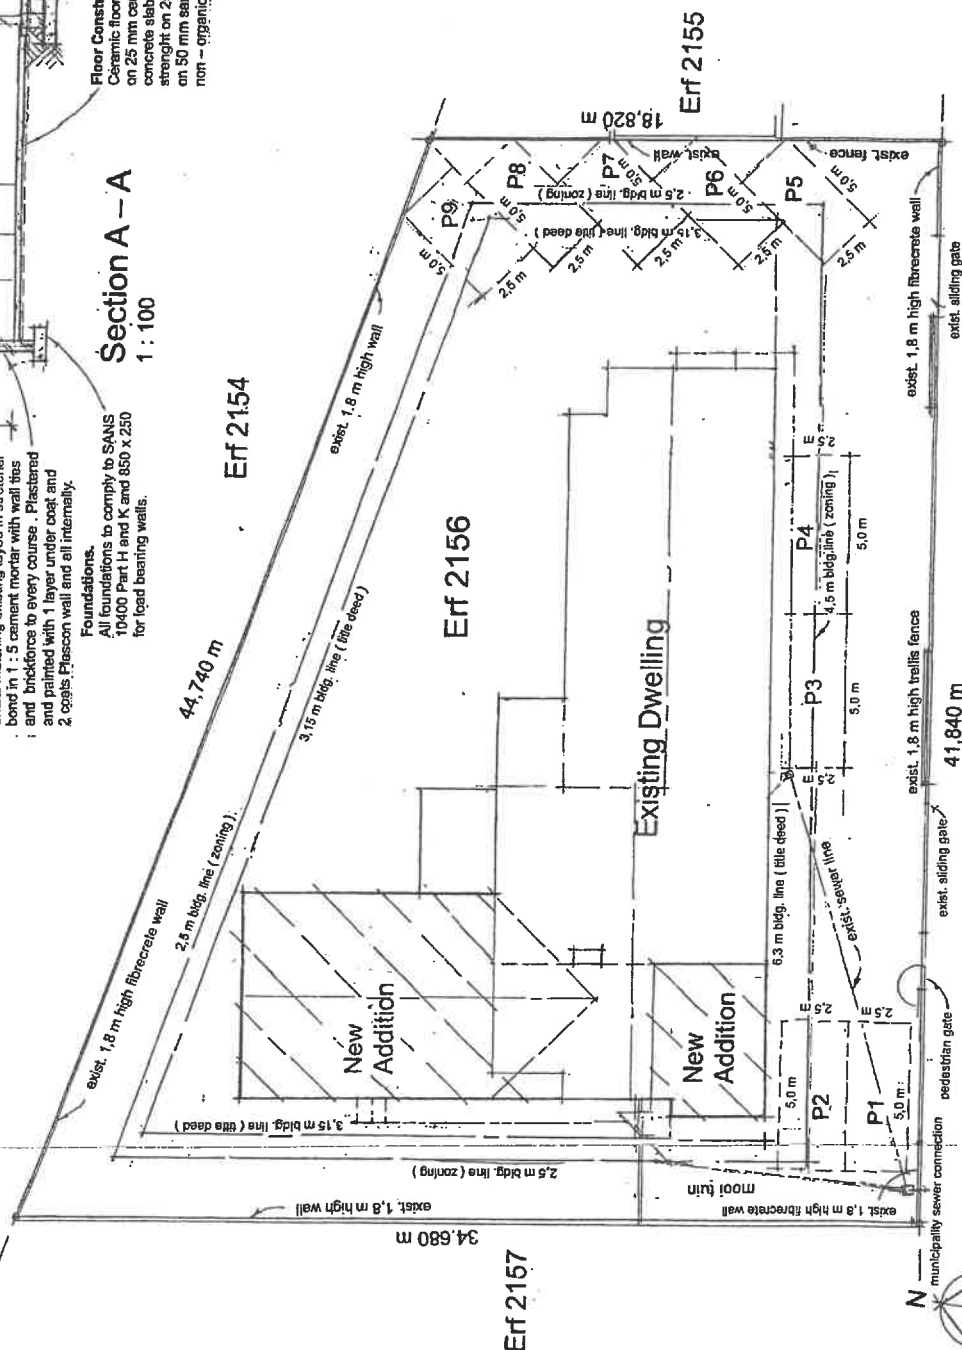

Site Plan
1 : 200

Merriman Avenue

ANNEXURE F

APPLICATION FOR A CONSENT USE: ERF 2156, STELLENBOSCH

COMMENT FROM THE MANAGER:
ELECTRICAL SERVICES

ERF 2156, STELLENBOSCH - TP1281/2025

1. No Objection

CONDITIONS:

2. Appropriate caution shall be taken during construction, to prevent damage to existing service cables and electrical equipment in the vicinity. Should damage occur, the applicant will be liable for the cost involved repairing damages.
3. **All electrical work to comply with SANS142 and Municipal electrical by-laws**

Bradley Williams

Date.....16/10/2025.....



Signature