



STELLENBOSCH
 STELLENBOSCH • PNIEL • FRANSCHHOEK
 MUNISIPALITEIT • UMASIPALA • MUNICIPALITY

Application Number: LU/13918

Our File Reference Number: Erf 16442, Stellenbosch

Your Reference Number:

Enquiries: Ulrich von Molendorff

Contact No: 021 – 808 8682

Email address: Ulrich.Vonmolendorff@stellenbosch.gov.za

PER E-MAIL: [REDACTED]

Sir / Madam

APPLICATION FOR AMENDMENT OF A CONDITION OF APPROVAL TO AMEND AN APPROVED SITE DEVELOPMENT PLAN ON ERF 16442 STELLENBOSCH.

1. The above application refers.
2. The duly authorised decision maker hereby decides on the above application as follows.
3. That the following application(s) in terms of Section 15(2) of the Stellenbosch Municipal Land Use Planning Bylaw, promulgated by notice number 354/2015, dated 20 October 2015 on Erf 16442, Stellenbosch, namely;
 - 3.1. **Amendment of condition of approval** in terms of Section 15 (2)(h) of the said by-law to amend an approved site development plan on Erf 16442 Stellenbosch in order to accommodate the additional apartment on the third floor,

BE APPROVED in terms of Section 60 of the said bylaw, subject to conditions in terms of Section 66 of the said Bylaw.

4. Conditions of Approval:


- 4.1. The approval applies only to the proposed application under consideration as indicated on Site Development Plan No:3584/C/101, 201, 202, 203, 204, 205 drawn by TV3 Architects and Town Planners, dated 2023/04/12 (See **Annexure A**); and shall not be construed as authority to depart from any other legal prescriptions or requirements from Council;
- 4.2. The approval granted shall not exempt the applicant from complying with any other legal prescriptions or requirements that might have a bearing on the proposed use;
- 4.3. The development must be undertaken in accordance with Site Development Plan No:3584/C/101, 201, 202, 203, 204, 205 drawn by TV3 Architects and Town Planners, dated 2023/04/12 (See **Annexure A**) to this report.
- 4.4. Building plans must be submitted in accordance with the site plan, and be approved by this Municipality, prior to any building work commencing on site.

- 4.5. Development contributions are payable in accordance with the prevailing and applicable Council Tariffs at the time of payment prior to the transfer of the first property or submission of any building plans, whichever occurs first, or as may be agreed on in writing with the Director Infrastructure Services.
5. The reasons for the above decision are as follows:
- 5.1. The proposed amendment on the SDP only entails internal design changes, and the changes are in line with Stellenbosch Municipality Zoning Scheme By-law.
- 5.2. These land uses will be contained in the development envelope already approved.
- 5.3. All other land use parameters will still be complied with as initially approved.
6. You are hereby informed in terms of section 79(2) of the Stellenbosch Municipal Land Use Planning Bylaw, 201be 5, of your right to appeal the above decision to the Appeal Authority within 21 days from the date of notification of the above decision. Please note that no late appeals or an extension of time for the submission of appeals are permitted in terms of Section 80(1)(a) of the said By-Law.
7. Appeals must be submitted with the prescribed information to satisfy the requirements of Section 80(2) of the said By-law, failing which the appeal will be invalid in terms of Section 81(1)(b) of the said By-Law. The following prescribed information is accordingly required:
- (a) The personal particulars of the Appellant, including:
- First names and surname
 - ID number
 - Company of Legal person's name (if applicable)
 - Physical Address
 - Contact details, including a Cell number and E-Mail address
- (b) Reference to this correspondence and the relevant property details on which the appeal is submitted.
- (c) The grounds of the appeal which may include the following grounds:
- that the administrative action was not procedurally fair as contemplated in the Promotion of Administrative Justice Act, 2000 (Act 3 of 2000)
 - grounds relating to the merits of the land development or land use application on which the appellant believes the authorised decision maker erred in coming to the conclusion it did.
- (d) Whether the appeal is lodged against the whole decision or a part of the decision.
- (e) If the appeal is lodged against a part of the decision, a description of the part.
- (f) If the appeal is lodged against a condition of approval, a description of the condition.
- (g) The factual or legal findings that the appellant relies on.
- (h) The relief sought by the appellant.
- (i) Any issue that the appellant wishes the Appeal Authority to consider in making its decision.
- (j) That the appeal includes the following declaration by the Appellant:
- The Appellant confirms that the information contained in the subject appeal and accompanied information and documentation is complete and correct
 - That the Appellant is aware that it is an offence in terms of Section 86(1)(d) of the said By-Law to supply particulars, information or answers in an appeal against a decision on

an application, or in any documentation or representation related to an appeal, knowing it to be false, incorrect or misleading or not believing them to be correct.

8. Appeals must be addressed to the Municipal Manager and submitted to his/ her designated official by means of e-mail at the following address: landuse.appeals@ Stellenbosch.gov.za.
9. Any party (applicant or other) who lodges an appeal must pay the applicable appeal fee in terms of the approved municipal tariffs and submit the proof of payment together with the appeal. The **LU** Reference number on this correspondence, or the applicable Erf/ Farm Number must be used as the reference for the payment of the appeal fee.
10. The approved tariff structure and the banking details for the General Account can be accessed and viewed on the municipal website. For any enquiries the office can be contacted at landuse.appeals@ Stellenbosch.gov.za.
11. An applicant who lodges an appeal must also adhere to the following requirements stipulated in terms of section 80(3) to (7) of the said By-law:
 - (a) Simultaneously serve the appeal on any person who commented on the application concerned and any other person as the municipality may determine.
 - (b) The notice by the applicant must invite persons to comment on the appeal within 21 days from date of notification of the appeal.
 - (c) The notice must be served in accordance with section 35 of the said legislation and in accordance with the prescripts or such additional requirements as may be determined by the Municipality.
 - (d) Proof of serving the notification must be submitted to the Municipality at the above E-mail address within 14 days of serving the notification.
12. Kindly note that no appeal right exists in terms of Section 62 of the Local Government Municipal Systems Act, No 32 of 2000.
13. Kindly note the above decision in the case of any approval, is suspended, and may therefore not be acted on, until such time as the period for lodging appeals has lapsed, any appeal has been finalised and you've been advised accordingly.


Yours faithfully,

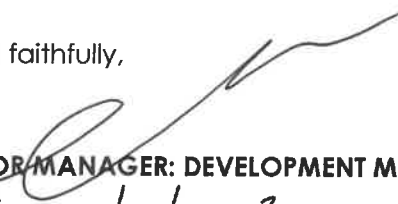
SENIOR MANAGER: DEVELOPMENT MANAGEMENT

DATE:

21/4/2023

ANNEXURE A: SITE DEVELOPMENT PLAN

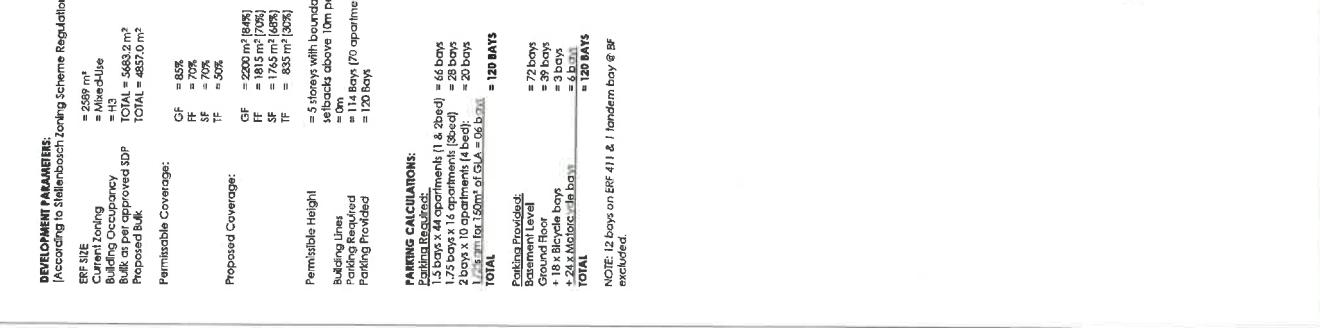[illegible]

ADAM TAS ROAD - R310

STANDLER STREET

DORP STREET

GROUND STOREY PLAN
SCALE 1 : 125

DATE: _____
DRAWN: N. CRANK PACHO 26/10/09
CHECKED: _____
SCALE: 1 : 125
DRAWING NO.: **3584 / C / 202**
FOR INFORMATION

PROJECT / CLIENT:
No2. DORP_MySpace
lv3
ARCHITECTS AND TOWN PLANNERS

PROJECT DESCRIPTION:
**ERF 16442 STELLENBOSCH
NEW APARTMENT BUILDING**

DRAWING DESCRIPTION:
SDP GROUND FLOOR

DRAWING STATUS CODES:

ALL DIMENSIONS ARE IN METERS UNLESS OTHERWISE SPECIFIED.
ALL DIMENSIONS ARE TO FACE UNLESS OTHERWISE SPECIFIED.









SCALE 1:20

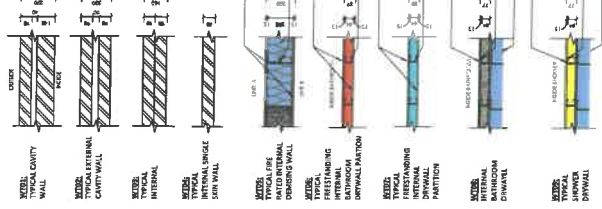

FIRST STOREY PLAN
SCALE 1 : 125

[illegible]

DRAWING STATUS CODES:


PROJECT DESCRIPTION:
ERF 16442 STELLENBOSCH
NEW APARTMENT BUILDING

PROJECT / CLIENT:

No2. DORP_MySpace

DATE: _____
DRAWN: _____
CHECKED: _____
SCALE: _____

DRAWING No.:
3584 / C / 203

FOR INFORMATION





[illegible]

FOR INFORMATION

ARCHITECTS AND TOWN PLANNERS

WALL TYPE LEGEND
SCALE 1:20

SCALE 1:20

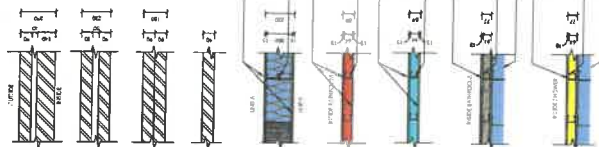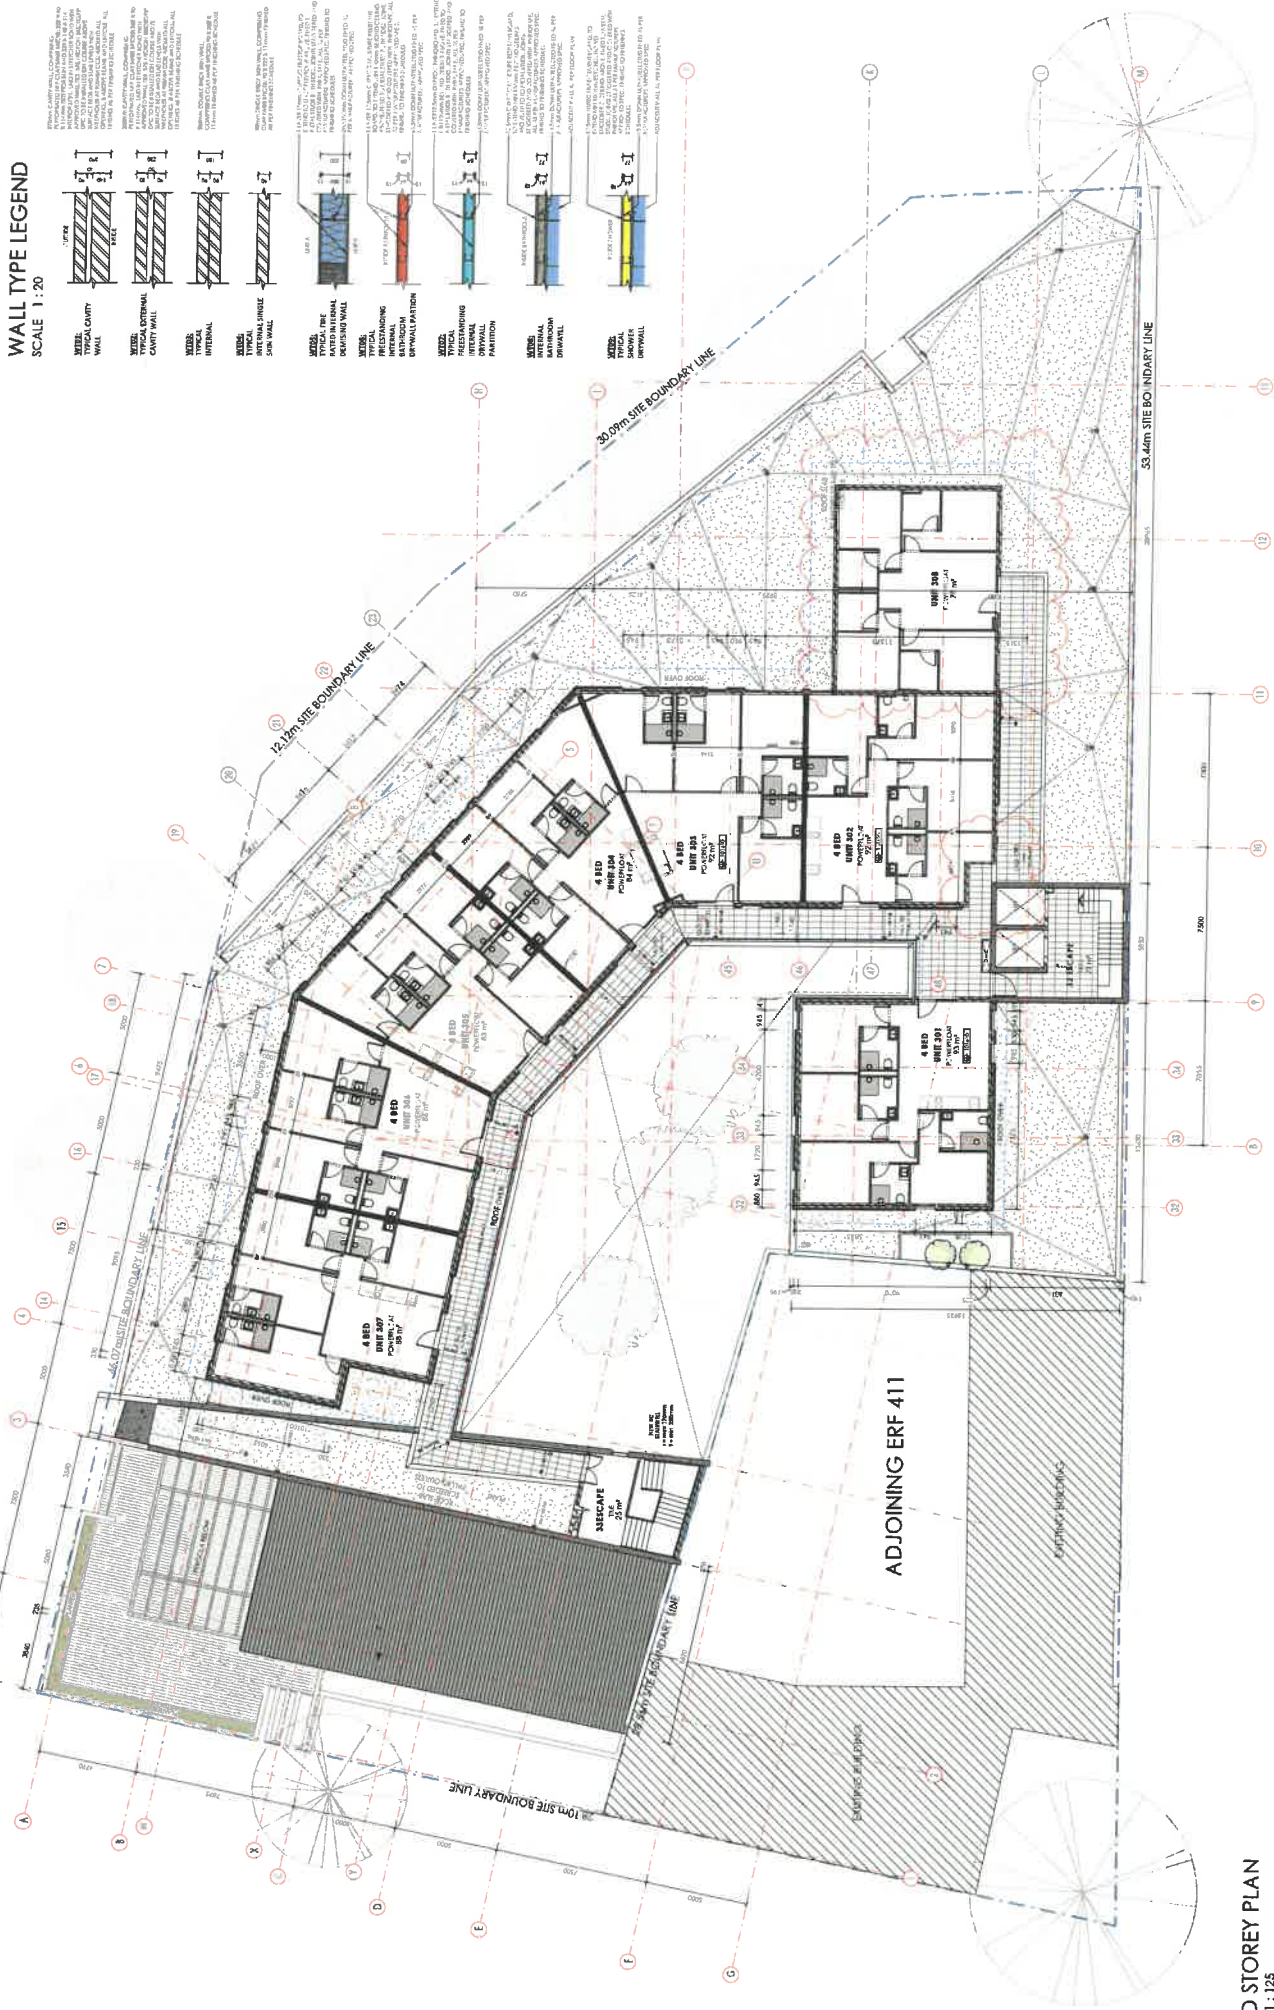

THIRD STOREY PLAN
SCALE 1:125

ORIGINAL DOCUMENT DATE: _____ DATE: _____
DOCUMENT VARIATIONS REGISTER: _____

NO	DATE	DESCRIPTION
A	2025 04 31	ADDITIONAL UNIT ADDED TO 3RD FLOOR

DRAWING STATUS CODES:

A. Design • B. Marketing • C. Municipal • D. Tender • E. Construction • F. As-Built

PROJECT DESCRIPTION:
ERF 16442 STELLENBOSCH
NEW APARTMENT BUILDING

DRAWING DESCRIPTION:
SDP THIRD FLOOR

PROJECT / CLIENT:

No2. DORP MySpace

Architects and Town Planners

DATE: 2023-04-12
DRAWN: N. CRANK P1ARCH24745109
CHECKED: N/C

DRAWING No.: **3584 / C / 205**

FOR INFORMATION